

**SURVEY &  
REMONUMENTATION**

LIBER **1810** PAGE **639**

STATE OF MICHIGAN  
COUNTY OF MUSKEGON  
RECEIVED FOR RECORD

APR 28 1995

1994 DEC 29 AM 10:19

**LAND CORNER RECORDATION CERTIFICATE**  
Filing Requirement of Act 74, Mich. P.A. 1970

*Carrie Carter*  
REGISTER OF DEEDS

For corners in  
Muskegon  
COMMISSION  
(County)

Located In: Corner Code #

|                                    |                             |       |
|------------------------------------|-----------------------------|-------|
| 1. Public Land Survey              | T <u>11</u> N R <u>16</u> W | I 5   |
|                                    | T ___ R ___                 | _____ |
|                                    | T ___ R ___                 | _____ |
|                                    | T ___ R ___                 | _____ |
| 2. Property Controlling in Section | S ___ T ___ R ___           | _____ |
|                                    | S ___ T ___ R ___           | _____ |
| 3. Miscellaneous Property in Sec.  | S ___ T ___ R ___           | _____ |
|                                    | S ___ T ___ R ___           | _____ |

*A 1663*

Register of Deeds Stamp & File Number

4. Lot No. \_\_\_\_\_, Recorded Plat \_\_\_\_\_  
5. Private Claims \_\_\_\_\_

| A  | B  | C  | D  | E  | F  | G  | H | I | J | K | L | M |
|----|----|----|----|----|----|----|---|---|---|---|---|---|
| 2  | 5  | 5  | 4  | 3  | 2  | 1  |   |   |   |   |   |   |
| 3  |    |    |    |    |    |    |   |   |   |   |   |   |
| 4  | 7  | 8  | 9  | 10 | 11 | 12 |   |   |   |   |   |   |
| 5  |    |    |    |    |    |    |   |   |   |   |   |   |
| 6  | 18 | 17 | 16 | 15 | 14 | 13 |   |   |   |   |   |   |
| 7  |    |    |    |    |    |    |   |   |   |   |   |   |
| 8  | 19 | 20 | 21 | 22 | 23 | 24 |   |   |   |   |   |   |
| 9  |    |    |    |    |    |    |   |   |   |   |   |   |
| 10 | 30 | 29 | 28 | 27 | 26 | 25 |   |   |   |   |   |   |
| 11 |    |    |    |    |    |    |   |   |   |   |   |   |
| 12 | 31 | 32 | 33 | 34 | 35 | 36 |   |   |   |   |   |   |
| 13 |    |    |    |    |    |    |   |   |   |   |   |   |

I, Ralph W. VanRiper, in a field survey on November 4, 1994, do hereby certify that under requirements of P.A. 74, Michigan P.A. of 1970, the corner points mentioned in lines 1 and 2 above were in conformance with regulations and rules therefore as required in the current manual of survey instructions of the United States Department of the Interior, Bureau of Land Management or by a decree of a Court of Law and/or that the corner points mentioned in lines 3, 4 and 5 above were in conformance with the rules of the Michigan Board of Land Surveyors or by a Decree of a Court of Law; established, re-established, monumented, re-monumented, recovered, found as expressed below:

**NOTE: Not more than 4 corners, all in the same town and range, may be recorded on this certificate.**

**A. Description of original monument and accessories and/or subsequent restoration:**

Section corner between Sections 10, 11, 14 and 15,  
T 11 N, R 16 W, Dalton Township  
Set post June 22, 1837, by GLO Surveyors  
16" W Oak S 3° E 66 L  
18" Pine N 72° E 14 L

**B. Description of corner evidence found and/or method applied in restoring or reestablishing corner:**


Found 3/8" Re-rod as per Muskegon County Road Commission Witness Book, recorded by Donald G. Sandel, May 16, 1979 Liber 1168, Page 37

- P: Pole S44°W 41.87'
- 10" Tw Oak S28°E 65.73'
- 10" W. Pine N77°W 51.35'
- 24" Oak S86°W 48.69'

POSITION OF SAID  
RECORDED CORNER  
REVIEWED & RATIFIED  
BY MUSKEGON COUNTY  
PEER GROUP IN ACCORDANCE  
WITH P.A. 345, OF 1990  
*May 2, 1994*

**C. Description of monument for corner and accessories established to perpetuate locating the position of the corner:**

Set 2 3/4" Cast Iron Monument with  
County Survey Cap  
S 86° W 48.49' Fd. nail in 24" Oak  
N 77° W 51.35' Fd. nail in 10" W. Pine  
N 75° W 64.88' Set nail in 30" Oak  
S 44° W 41.85' Fd. nail in Power Pole  
S 28° E 65.73' Fd. nail in 12" Twin Oak

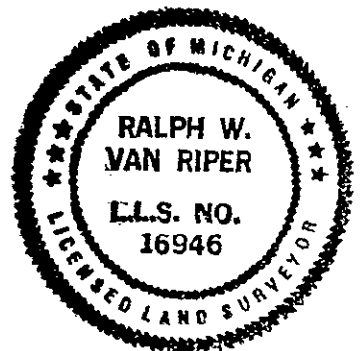

Signed by *Ralph W. Van Riper* Date 12/27/94  
Surveyor's Michigan License No. 16946