

COMMISSION

LAND CORNER RECORDATION CERTIFICATE
Filing Requirement of Act 74, Mich. P.A. 1970

Carlin Carter
REGISTER OF DEEDS

STATE OF MICHIGAN
COUNTY OF MUSKEGON
REGISTER OF DEEDS RECORD
1993 DEC 29 PM 3:08

For corners in

<u>Muskegon</u> (County)	Located In:	Corner Code //
1. Public Land Survey	T 11N R 16W	I 8
	T _____ R _____	_____
	T _____ R _____	_____
	T _____ R _____	_____
2. Property Controlling in Section	S _____ T _____ R _____	_____
	S _____ T _____ R _____	_____
3. Miscellaneous Property in Sec.	S _____ T _____ R _____	_____
	S _____ T _____ R _____	_____
4. Lot No. _____, Recorded Plat _____		
5. Private Claims _____		

Register of Deeds Stamp & File Number

A	B	C	D	E	F	G	H	I	J	K	L	M
2	6	5	4	3	2	1						
3												
4	7	8	9	10	11	12						
5												
6	18	17	16	15	14	13						
7												
8	19	20	21	22	23	24						
9												
10	30	29	28	27	26	25						
11												
12	31	32	33	34	35	36						
13												

I, Ralph W. VanRiper, in a field survey on May 28, 1993, do hereby certify that under requirements of P.A. 74, Michigan P.A. of 1970, the corner points mentioned in lines 1 and 2 above were in conformance with regulations and rules therefore as required in the current manual of survey instructions of the United States Department of the Interior, Bureau of Land Management or by a decree of a Court of Law and/or that the corner points mentioned in lines 3, 4 and 5 above were in conformance with the rules of the Michigan Board of Land Surveyors or by a Decree of a Court of Law; established, re-established, monumented, re-monumented, recovered, found as expressed below:

NOTE: Not more than 4 corners, all in the same town and range, may be recorded on this certificate.

A. Description of original monument and accessories and/or subsequent restoration:

1/4 Corner between Sections 22 and 23, T 11 N, R 16 W, Dalton Township
Post Set June 21, 1837 by GLO Surveyors
Beach 10" at Corner


B. Description of corner evidence found and/or method applied in restoring or reestablishing corner:

Found 5/8" Steel Rod. in Well Point S 53° W 63.50' 14" Pine
Recorded by Charles F. Lewandoski, RLS No. 7867 N 45° W 41.50' P. Pole
Liber 1186, Page 585 - Dec. 28, 1979 N 80° E 53.95' 24" Pine

Historical usage, documentation and evidence of corner location reviewed and ratified by Muskegon County Peer Group, May 18, 1993

C. Description of monument for corner and accessories established to perpetuate locating the position of the corner.

Set 4" by 20" Cast Iron Monument with County Survey Cap
N 67° E 29.69' Fd. Spike in 16" Pine
S 42° E 80.00' Fd. Spike in 24" Pine
S 48° W 76.05' Set Spike in 20" Pine
S 56° W 63.70' Fd. Spike in 18" Pine
N 60° W 48.55' Set Spike in 8" Pine
N 42° W 41.50' Fd. Spije in Power Pole

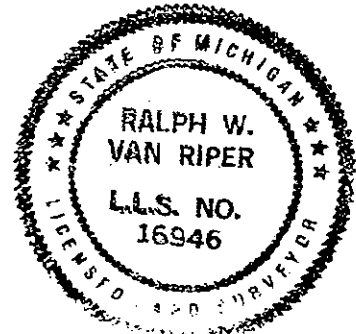

Signed by Ralph W. Van Riper Date Dec. 28, 1993
Surveyor's Michigan License No. 16946