

COMMISSION

LAND CORNER RECORDATION CERTIFICATE
Filing Requirement of Act 74, Mich. P.A. 1970

Carrie Carter
REGISTER OF DEEDS

STATE OF MICHIGAN
COUNTY OF MUSKEGON
RECEIVED FOR RECORD
1993 DEC 29 PM 3:08

For corners in

<u>Muskegon</u> (County)	Located In:	Corner Code #
1. Public Land Survey	T <u>11N</u> R <u>16W</u>	<u>I 9</u>
	T _____ R _____	_____
	T _____ R _____	_____
	T _____ R _____	_____
2. Property Controlling in Section	S _____ T _____ R _____	_____
	S _____ T _____ R _____	_____
3. Miscellaneous Property in Sec.	S _____ T _____ R _____	_____
	S _____ T _____ R _____	_____
4. Lot No. _____, Recorded Plat _____		
5. Private Claims _____		

Register of Deeds Stamp & File Number

I, Ralph W. VanRiper, in a field survey on May 28, 1993, do hereby certify that under requirements of P.A. 74, Michigan P.A. of 1970, the corner points mentioned in lines 1 and 2 above were in conformance with regulations and rules therefore as required in the current manual of survey instructions of the United States Department of the Interior, Bureau of Land Management or by a decree of a Court of Law and/or that the corner points mentioned in lines 3, 4 and 5 above were in conformance with the rules of the Michigan Board of Land Surveyors or by a Decree of a Court of Law; established, re-established, monumented, re-monumented, recovered, found as expressed below:

NOTE: Not more than 4 corners, all in the same town and range, may be recorded on this certificate.

A	B	C	D	E	F	G	H	I	J	K	L	M
2	6	5	4	3	2	1						
3												
4	7	8	9	10	11	12						
5												
6	18	17	16	15	14	13						
7												
8	19	20	21	22	23	24						
9												
10	30	29	28	27	26	25						
11												
12	31	32	33	34	35	36						
13												

A. Description of original monument and accessories and/or subsequent restoration:

Section Corner common to Sections 22, 23, 26 and 27, T 11 N, R 16 W, Dalton Township
 Post set June 21, 1837 by GLO Surveyors
 Hemlock 9" S 06° E 23 L
 Hemlock 10" N 39° W 07 L


B. Description of corner evidence found and/or method applied in restoring or reestablishing corner:

Found 3/4" Steel Rod, Recorded by Francis F. Smith F.F.S. = Spike in 8" Pine SE 48.60'
 RLS No. 3538, Liber 976, Page 793 and Charles F. Spike in 10" T.Ch. SW 58.80'
 Lewandoski, RLS No. 7867, Liber 1201, Page 471 Spike in 8" Pine NE 58.00'

Historical usage, documentation and evidence of corner location reviewed and ratified by Muskegon County Peer Group, May 18, 1993 C.F.L. = N 40° E 52.15' Guy Pole
 S 25° E 34.05' 8" Pine
 N 30° E 58.00' 8" Pine
 S 28° W 58.80' 10" T. Cherry

C. Description of monument for corner and accessories established to perpetuate locating the position of the corner:

Set 4" by 20" Cast Iron Monument with County Survey Cap
 N 30° E 58.03' Fd. Spike in 12" Pine
 N 58° E 54.98' Set Spike in 14" Pine
 S 25° E 34.01' Fd. Spike in 10" Pine
 S 28° W 58.80' Fd. Spike in Twin 12" Cherry
 S 35° W 37.97' Set Spike in Guy Pole
 N 40° W 52.14' Fd. Spike in Guy Pole

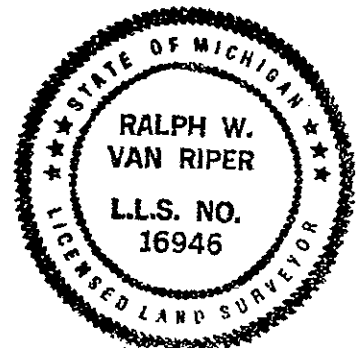

Signed by Ralph W. Van Riper
 Surveyor's Michigan License No. 16946

Date Dec. 28, 1993