

COMMISSION

LAND CORNER RECORDATION CERTIFICATE
Filing Requirement of Act 74, Mich. P.A. 1970

STATE OF MICHIGAN
COUNTY OF MUSKEGON
RECEIVED FOR RECORD
1993 DEC 29 PM 3:08
Carter
REGISTER OF DEEDS

For corners in

Muskegon (County) Located In: Corner Code //

1. Public Land Survey T 11N R 16W I 10
T R
T R
T R

2. Property Controlling in Section S T R
S T R

3. Miscellaneous Property in Sec. S T R
S T R

4. Lot No. , Recorded Plat

5. Private Claims

Register of Deeds Stamp & File Number

A	B	C	D	E	F	G	H	I	J	K	L	M
2	6	5	4	3	2	1						
3												
4	7	8	9	10	11	12						
5												
6	18	17	16	15	14	13						
7												
8	19	20	21	22	23	24						
9												
10	30	29	28	27	26	25						
11												
12	31	32	33	34	35	36						
13												

I, Ralph W. VanRiper, in a field survey on June 4, 19 93, do hereby certify that under requirements of P.A. 74, Michigan P.A. of 1970, the corner points mentioned in lines 1 and 2 above were in conformance with regulations and rules therefore as required in the current manual of survey instructions of the United States Department of the Interior, Bureau of Land Management or by a decree of a Court of Law and/or that the corner points mentioned in lines 3, 4 and 5 above were in conformance with the rules of the Michigan Board of Land Surveyors or by a Decree of a Court of Law; established, re-established, monumented, re-monumented, recovered, found as expressed below:

NOTE: Not more than 4 corners, all in the same town and range, may be recorded on this certificate.

A. Description of original monument and accessories and/or subsequent restoration:

1/4 Corner between Sections 26 and 27, T 11 N, R 16 W, Dalton Township

Post set June 21, 1837 by GLO Surveyors

Birch 8" S 18° W 34 L
Sassafras 6" N 40° W 13 L

B. Description of corner evidence found and/or method applied in restoring or reestablishing corner:


Found 1" Pinched Pipe N 75° W 69.28' 10" W. Cherry
Recorded by Charles F. Lewandoski, RLS No. 7867 S 28° W 72.72' 12" Poplar
Liber 1186, Page 583, Dec. 28, 1979 S 07° W 11.03' 12" Tr. W. Cherry
N 81° E 78.25' 10" TW. W. Cherry

Historical usage, documentation and evidence of corner location reviewed and ratified by Muskegon County Peer Group June 1, 1993

C. Description of monument for corner and accessories established to perpetuate locating the position of the corner:

Set 4" by 20" Cast Iron Monument with County Survey Cap

N 85° E 78.28' Fd. Spike in Twn. 10" W. Cherry
South 29.35' Set Spike in 12" Pine
S 33° W 72.74' Fd. Spike in 12" Poplar
S 88° W 34.60' Set Spike in 8" W. Cherry
N 71° W 69.28' Fd. Spike in 12" W. Cherry
N 05° W 75.00' Set Spike in Tw. 6" Oak

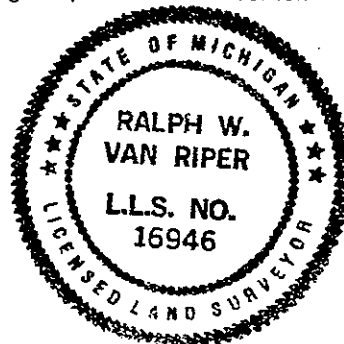

Signed by Ralph W. Van Riper

Date Dec. 28, 1993

Surveyor's Michigan License No. 16946