

COMMISSION

LAND CORNER RECORDATION CERTIFICATE
Filing Requirement of Act 74, Mich. P.A. 1970

For corners in

| | | |
|--|---------------------------|----------------|
| <u>Muskegon</u> <small>(County)</small> | Located In: | Corner Code =# |
| 1. Public Land Survey | T <u>11N</u> R <u>16W</u> | <u>I 11</u> |
| | T _____ R _____ | _____ |
| | T _____ R _____ | _____ |
| | T _____ R _____ | _____ |
| 2. Property Controlling in Section | S _____ T _____ R _____ | _____ |
| | S _____ T _____ R _____ | _____ |
| 3. Miscellaneous Property in Sec. | S _____ T _____ R _____ | _____ |
| | S _____ T _____ R _____ | _____ |

Carrie Carter
REGISTER OF DEEDS

STATE OF MICHIGAN
COUNTY OF MUSKEGON
REGISTER OF DEEDS
1993 DEC 29 PM 3:08

Register of Deeds Stamp & File Number

- 4. Lot No. _____, Recorded Plat _____
- 5. Private Claims _____

| A | B | C | D | E | F | G | H | I | J | K | L | M |
|----|----|----|----|----|----|----|---|---|---|---|---|---|
| 2 | 6 | 5 | 4 | 3 | 2 | 1 | | | | | | |
| 3 | | | | | | | | | | | | |
| 4 | 7 | 3 | 9 | 10 | 11 | 12 | | | | | | |
| 5 | | | | | | | | | | | | |
| 6 | 18 | 17 | 16 | 15 | 14 | 13 | | | | | | |
| 7 | | | | | | | | | | | | |
| 8 | 19 | 20 | 21 | 22 | 23 | 24 | | | | | | |
| 9 | | | | | | | | | | | | |
| 10 | 30 | 29 | 28 | 27 | 26 | 25 | | | | | | |
| 11 | | | | | | | | | | | | |
| 12 | 31 | 32 | 33 | 34 | 35 | 36 | | | | | | |
| 13 | | | | | | | | | | | | |

I, Ralph W. VanRiper, in a field survey on June 7, 1993, do hereby certify that under requirements of P.A. 74, Michigan P.A. of 1970, the corner points mentioned in lines 1 and 2 above were in conformance with regulations and rules therefore as required in the current manual of survey instructions of the United States Department of the Interior, Bureau of Land Management or by a decree of a Court of Law and/or that the corner points mentioned in lines 3, 4 and 5 above were in conformance with the rules of the Michigan Board of Land Surveyors or by a Decree of a Court of Law; established, re-established, monumented, re-monumented, recovered, found as expressed below:

NOTE: Not more than 4 corners, all in the same town and range, may be recorded on this certificate.

A. Description of original monument and accessories and/or subsequent restoration:

Section Corner common to Sections 26, 27, 34 and 35, T 11 N, R 16 W, Dalton Township

Post set June 21, 1837 by GLO Surveyors

- Beech 12" S 72° E 24 L
- Beech 8" N 39° W 40 L


B. Description of corner evidence found and/or method applied in restoring or reestablishing corner:

| | | |
|--|------------|------------|
| Found 1/4" Rod in Well Point as per | SW 40.82' | 12" Cherry |
| Muskegon County Road Comm. Witness Book | NNW 30.9' | P.P. |
| | SSE 26.95' | 10" W. O. |
| Historical usage, documentation and evidence | NE 32.24' | Ch. |
| of corner location reviewed and ratified by | NW 119.69' | Ch. |
| Muskegon County Peer Group, June 1, 1993 | | |

C. Description of monument for corner and accessories established to perpetuate locating the position of the corner:

Set 4" by 20" Cast Iron Monument with County Survey Cap

- N 21° E 35.40' Fd. Spike in 10" Tree
- S 65° E 48.51' Set Spike in 8" Ash
- S 08° E 26.84' Fd. Spike in 24" Oak
- S 17° W 40.73' Set Spike in 10" Box Elder
- S 57° W 40.85' Fd. Spike in 16" W. Cherry
- N 20° W 30.90' Fd. Spike in Power Pole

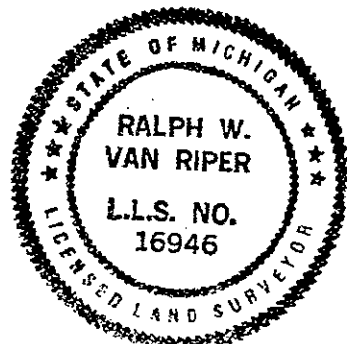

Signed by Ralph W. Van Riper Date Dec. 28, 1993
 Surveyor's Michigan License No. 16946