

COMMISSION

LAND CORNER RECORDATION CERTIFICATE  
Filing Requirement of Act 74, Mich. P.A. 1970

STATE OF MICHIGAN  
COUNTY OF MUSKEGON  
REGISTER OF DEEDS  
RECEIVED FOR RECORD  
1993 DEC 29 PM 3:09  
Collin Carter  
REGISTER OF DEEDS

For corners in

<u>Muskegon</u> (County)	Located In:	Corner Code #/
1. Public Land Survey	T <u>11N</u> R <u>16W</u>	<u>I 12</u>
	T _____ R _____	_____
	T _____ R _____	_____
	T _____ R _____	_____
2. Property Controlling in Section	S _____ T _____ R _____	_____
	S _____ T _____ R _____	_____
3. Miscellaneous Property in Sec.	S _____ T _____ R _____	_____
	S _____ T _____ R _____	_____

Register of Deeds Stamp & File Number

- 4. Lot No. \_\_\_\_\_, Recorded Plat \_\_\_\_\_
- 5. Private Claims \_\_\_\_\_

A	B	C	D	E	F	G	H	I	J	K	L	M
2	6	5	4	3	2	1						
3												
4	7	8	9	10	11	12						
5												
6	18	17	16	15	14	13						
7												
8	19	20	21	22	23	24						
9												
10	30	29	28	27	26	25						
11												
12	31	32	33	34	35	36						
13												

I, Ralph W. VanRiper, in a field survey on Oct. 6, 19 93  
do hereby certify that under requirements of P.A. 74, Michigan P.A. of 1970, the corner points mentioned  
in lines 1 and 2 above were in conformance with regulations and rules therefore as required in the  
current manual of survey instructions of the United States Department of the Interior, Bureau of Land  
Management or by a decree of a Court of Law and/or that the corner points mentioned in lines 3, 4 and 5  
above were in conformance with the rules of the Michigan Board of Land Surveyors or by a Decree of a  
Court of Law; established, re-established, monumented, re-monumented, recovered, found as  
expressed below:

NOTE: Not more than 4 corners, all in the same town and range, may be recorded  
on this certificate.

A. Description of original monument and accessories and/or subsequent restoration:

1/4 Corner between Sections 34 and 35, T 11 N, R 16 W, Dalton Township  
Set Post June 21, 1837 by GLO Surveyors

B. Description of corner evidence found and/or method applied in restoring or reestablishing corner:


Set 4" by 20' Cast Iron Monument with County Survey Cap, 5.65' West of corner in Muskegon  
County Road Commission Witness Book. This location is the extension of the Southwest corner  
of Section 35 and Concrete Monuments along the West line of Section 35 from Eklund's Sub.  
and Eklund's Sub. No. 1 as surveyed by Edward Scharmer, Jr., RLS No. 4156 to intersect the  
East and West 1/4 line of Section 35 from a survey by Maurice M Buck, Reg. C. E. & Land  
Surveyor of the Northwest 1/4 of the Southwest 1/4 of said Section in March of 1930.

This location was reviewed and ratified by the Muskegon County Peer Group, Oct 5, 1993

C. Description of monument for corner and accessories established to perpetuate locating the position of the corner:

Set 4" by 20" Cast Iron Monument with County Survey Cap

- N 44° E 52.22' Set Spike in Fence Post
- East 5.65' Fd. 1" Steel Pipe
- S 89° E 5.94' Set Spike in Power Pole
- S 24° E 88.12' Set Spike in 8" Oak
- N 62° W 65.57' Set Spike in 14" Pine
- N 32° W 19.24' Set Spike in 4" Oak

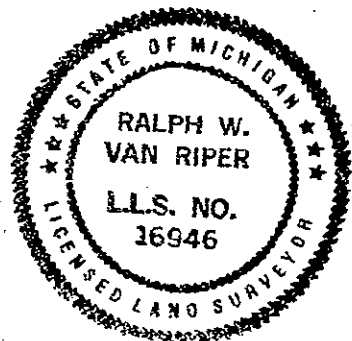

Signed by Ralph W. Van Riper

Date Dec. 28, 1993

Surveyor's Michigan License No. 16946