

**SURVEY &
REMONUMENTATION**

LIBER **1810** PAGE **644**

APR 28 1995

STATE OF MICHIGAN
COUNTY OF MUSKEGON
RECEIVED FOR RECORD

1994 DEC 29 AM 10:19

COMMISSION

LAND CORNER RECORDATION CERTIFICATE
Filing Requirement of Act 74, Mich. P.A. 1970

Carrie Carter
REGISTER OF DEEDS

For corners in

Muskegon (County)	Located In:	Corner Code ##
1. Public Land Survey	T <u>11</u> N R <u>16</u> W	<u>J 6</u>
	T _____ R _____	_____
	T _____ R _____	_____
	T _____ R _____	_____
2. Property Controlling in Section	S _____ T _____ R _____	_____
	S _____ T _____ R _____	_____
3. Miscellaneous Property in Sec.	S _____ T _____ R _____	_____
	S _____ T _____ R _____	_____

A 1668

Register of Deeds Stamp & File Number

4. Lot No. _____, Recorded Plat _____
5. Private Claims _____

I, Ralph W. VanRiper, in a field survey on December 8, 1994, do hereby certify that under requirements of P.A. 74, Michigan P.A. of 1970, the corner points mentioned in lines 1 and 2 above were in conformance with regulations and rules therefore as required in the current manual of survey instructions of the United States Department of the Interior, Bureau of Land Management or by a decree of a Court of Law and/or that the corner points mentioned in lines 3, 4 and 5 above were in conformance with the rules of the Michigan Board of Land Surveyors or by a Decree of a Court of Law; established, re-established, monumented, re-monumented, recovered, found as expressed below:

NOTE: Not more than 4 corners, all in the same town and range, may be recorded on this certificate.

A. Description of original monument and accessories and/or subsequent restoration:


Center of Section 14, T 11 N, R 16 W, Dalton Township

Not set by GLO Surveyors

B. Description of corner evidence found and/or method applied in restoring or reestablishing corner:

Found 1/2" rod as per Muskegon County Road Commission
Witness book.

NNE 34.81' 24" Oak
East 24.50' 16" Ash

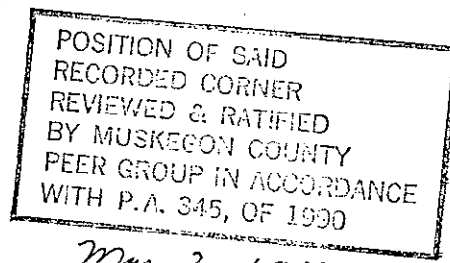

May 2, 1994 JW

C. Description of monument for corner and accessories established to perpetuate locating the position of the corner:

Set 2 3/4" Cast Iron Monument with County Surveyor Cap.

S 73° E 24.78' Fd. nail N side 24" Ash
N 42° E 35.15' Fd. nail N side 24" Oak
S 45° W 16.55' Fd. nail S side Twin 6" Maple
N 65° W 7.12' Fd. nail N side 10" Oak
West 12.32' Set nail N side 6" Oak
East 11.84' Set nail S side 6" Oak



Signed by *Ralph W. Van Riper*

Date 12/27/94

Surveyor's Michigan License No. 16946