

1993

LIBER 1744 PAGE 418

COMMISSION

LAND CORNER RECORDATION CERTIFICATE  
Filing Requirement of Act 74, Mich. P.A. 1970

For corners in

Muskegon  
(County)

Located In:

Corner Code //

- 1. Public Land Survey            T 11N R 16W            J 7
- T \_\_\_\_\_ R \_\_\_\_\_
- T \_\_\_\_\_ R \_\_\_\_\_
- T \_\_\_\_\_ R \_\_\_\_\_
- 2. Property Controlling        S \_\_\_\_\_ T \_\_\_\_\_ R \_\_\_\_\_
- in Section                    S \_\_\_\_\_ T \_\_\_\_\_ R \_\_\_\_\_
- 3. Miscellaneous                S \_\_\_\_\_ T \_\_\_\_\_ R \_\_\_\_\_
- Property in Sec.            S \_\_\_\_\_ T \_\_\_\_\_ R \_\_\_\_\_
- 4. Lot No. \_\_\_\_\_, Recorded Plat \_\_\_\_\_
- 5. Private Claims \_\_\_\_\_

Carlie Carter  
REGISTER OF DEEDS  
1973 DEC 29 PM 3:08  
STATE OF MICHIGAN  
COUNTY OF MUSKEGON  
RECEIVED FROM RECORD

Register of Deeds Stamp & File Number

I, Ralph W. VanRiper, in a field survey on May 27, 1993, 19\_\_\_\_, do hereby certify that under requirements of P.A. 74, Michigan P.A. of 1970, the corner points mentioned in lines 1 and 2 above were in conformance with regulations and rules therefore as required in the current manual of survey instructions of the United States Department of the Interior, Bureau of Land Management or by a decree of a Court of Law and/or that the corner points mentioned in lines 3, 4 and 5 above were in conformance with the rules of the Michigan Board of Land Surveyors or by a Decree of a Court of Law; established, re-established, monumented, re-monumented, recovered, found as expressed below:

NOTE: Not more than 4 corners, all in the same town and range, may be recorded on this certificate.

A	B	C	D	E	F	G	H	I	J	K	L	M
2	6	5	4	3	2	1						
3												
4	7	8	9	10	11	12						
5												
6	16	17	16	15	14	13						
7												
8	19	20	21	22	23	24						
9												
10	30	29	28	27	26	25						
11												
12	31	32	33	34	35	36						
13												

A. Description of original monument and accessories and/or subsequent restoration:

1/4 Corner between Sections 14 and 23, T 11 N, R 16 W, Dalton Township  
Post set June 21, 1837 by GLO Surveyors  
Hemlock 18" S 65° E 20 L  
Hemlock 24" N 64° W 32 L


B. Description of corner evidence found and/or method applied in restoring or reestablishing corner:

Found 1/2" Steel Rod over 1" Steel Pipe in Monument Box	N 34.05'	Cor. of Fence Post
Recorded by John E. Lazarock, RLS No. 13587	NNE 42.60'	30" Maple
Liber 1148, Page 47, Aug. 31, 1978	SE 79.54'	Power Pole
	SW 51.67'	Tel. Pole
	SW 49.45'	Cor. Fence Post

Historical usage, documentation and evidence of corner location reviewed and ratified by Muskegon County Peer Group, May 18, 1993

C. Description of monument for corner and accessories established to perpetuate locating the position of the corner:

Set 2 3/4" by 20" Cast Iron Monument with County Survey Cap in Monument Box  
N 01° E 34.24' Set Spike in Fence Post  
N 18° E 42.60' Set Spike in 36" Maple  
N 67° E 74.20' Fd. Spike in Guy Pole  
S 54° E 79.50' Fd. Spike in Power Pole  
S 29° W 40.01' Set "X" in Conc. Curb  
S 40° W 51.59' Fd. Spike in Guy Pole

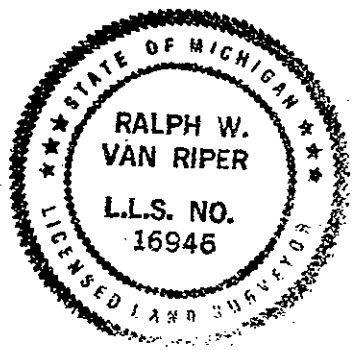

Signed by Ralph W. Van Riper Date Dec. 28, 1993

Surveyor's Michigan License No. 16946