, Recorded Plat


COMMISSION

LAND CORNER RECORDATION CERTIFICATE Filing Requirement of Act 74, Mich. P.A. 1970

For corners in		Filing Requirement of Act 74, Mich. P.A. 1970			
	Muskegon (County)	Located In:	Corner Code ##		OF R
1.	Public Land Survey	T 11N R 16W T R	J 8		NICHIGAN NUSKEGOND NUSKEGOND NUSKEGOND NUSKEGOND
2. 3.	Property Controlling in Section Miscellaneous Property in Sec.	S T R S T R S T R S T R		Register of	Deeds Stamp & File Number

I, Ralph W. VanRiper, in a field survey on May 28, 19, 93, do hereby certify that under requirements of P.A. 74, Michigan P.A. of 1970, the corner points mentioned in lines 1 and 2 above were in conformance with regulations and rules therefore as required in the current manual of survey instructions of the United States Department of the Interior, Bureau of Land Management or by a decree of a Court of Law and/or that the corner points mentioned in lines 3, 4 and 5 above were in conformance with the rules of the Michigan Board of Land Surveyors or by a Decree of a Court of Law; established, re-established, monumented, re-monumented, recovered, found as expressed below:

NOTE: Not more than 4 corners, all in the same town and range, may be recorded on this certificate.

 


Center of Section 23, T 11 N, R 16 W, Dalton Township

Not set by GLO Surveyors

4. Lot No.

Private Claims

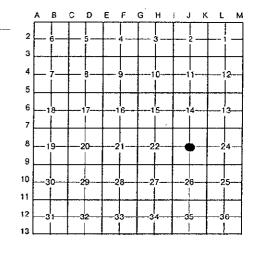

B. Description of corner evidence found and/or method applied in restoring or reestablishing corner:


Found Hex Head Bolt as per Muskegon Count	y N 40° E	45.65'	Clump 3" Map.
Road Commission Witness Book	S 68° E	56.94'	6" Pine
	S 52° W	34.36'	6" Tw. Map.
	\$.	19.5	Fence E
	S	24.0'	Fence W

Historical usage, documentation and evidence of corner location reviewed and ratified by Muskegon County Peer Group, May 18, 1993

C. Description of monument for corner and accessories established to perpetuate locating the position of the corner:

Set 4" by 20" Cast Iron Monument with County Survey Cap

N 40° E 45.66' Fd. Spike in Triple 6" Maple S 65° E 56.95' Fd. Spike in 12" Pine S 27° E 58.43' Set Spike in Triple 6" Maple S 50° W 34.06' Fd. Spike in Twin 10" Maple N 78° W 44.38' Set Spike in 14" Poplar N 45° W 52.23' Set Spike in 14" Poplar

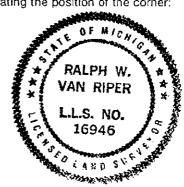

Signed by Kelfl W. On Typi

Date Dec. 28, 1993

Surveyor's Michigan License No. 16946