

1993

COMMISSION

LAND CORNER RECORDATION CERTIFICATE  
Filing Requirement of Act 74, Mich. P.A. 1970

STATE OF MICHIGAN  
COUNTY OF MUSKEGON  
RECEIVED FOR RECORD  
1993 DEC 29 PM 3:08  
Doris Carter  
REGISTER OF DEEDS

For corners in

Muskegon Located In: Corner Code //  
(County)

- 1. Public Land Survey T 11N R 16W J 9
- 2. Property Controlling S T R
- 3. Miscellaneous S T R
- 4. Lot No. Recorded Plat
- 5. Private Claims

Register of Deeds Stamp & File Number

I, Ralph W. VanRiper, in a field survey on May 28, 1993, 19\_\_\_\_, do hereby certify that under requirements of P.A. 74, Michigan P.A. of 1970, the corner points mentioned in lines 1 and 2 above were in conformance with regulations and rules therefore as required in the current manual of survey instructions of the United States Department of the Interior, Bureau of Land Management or by a decree of a Court of Law and/or that the corner points mentioned in lines 3, 4 and 5 above were in conformance with the rules of the Michigan Board of Land Surveyors or by a Decree of a Court of Law; established, re-established, monumented, re-monumented, recovered, found as expressed below:

NOTE: Not more than 4 corners, all in the same town and range, may be recorded on this certificate.

	A	B	C	D	E	F	G	H	I	J	K	L	M
2	6	5	4	3	2	1							
3													
4	7	8	9	10	11	12							
5													
6	18	17	16	15	14	13							
7													
8	19	20	21	22	23	24							
9													
10	30	29	28	27	26	25							
11													
12	31	32	33	34	35	36							
13													

A. Description of original monument and accessories and/or subsequent restoration:

1/4 Corner between Sections 23 and 26, T 11 N, R 16 W, Dalton Township  
Post set June 21, 1837 by GLO Surveyors  
Beech 9" S 31° E 28 L  
Beech 12" N 75° W 18 L


B. Description of corner evidence found and/or method applied in restoring or reestablishing corner:

Found 1 1/4" Pipe over 3/4" Pipe over 1/2" Rod SW 45.20' Cor. F. Post  
as per Muskegon Co. Rd. Commission Witness Book SE 77.58' P. P.  
SW 67.60' T. P.  
NW 187.25' Cor. School

Historical usage, documentation and evidence of corner location reviewed and ratified by Muskegon County Peer Group May 18, 1993

C. Description of monument for corner and accessories established to perpetuate locating the position of the corner:

Set 4" by 20" Cast Iron Monument with County Survey Cap  
N 45° E 213.07' Set Spike in 26" Oak  
S 55° E 77.51' Fd. Spike in Power Pole  
S 61° E 84.85' Set Spike in 10" Ash  
S 26° W 67.56' Set Spike in Tel. Pole  
N 49° W 187.23' SE corner of Conc. Hse Found.  
N 04° W 225.47' Set Spike in Tel. Pole

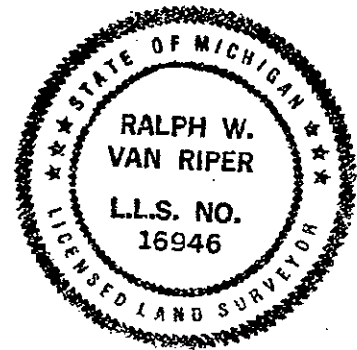

Signed by Ralph W. Van Riper Date Dec. 28, 1993  
Surveyor's Michigan License No. 16946