

1993

1744 PAGE 431

COMMITTEE

LAND CORNER RECORDATION CERTIFICATE
Filing Requirement of Act 74, Mich. P.A. 1970

STATE OF MICHIGAN
COUNTY OF MUSKEGON
RECEIVED FOR RECORD
1993 DEC 29 PM 3:08
Carrie Carter
REGISTER OF DEEDS

For corners in Muskegon (County) Located In: Corner Code #

1. Public Land Survey T 11N R 16W J 11
 T _____ R _____
 T _____ R _____
 T _____ R _____

2. Property Controlling S _____ T _____ R _____
 in Section S _____ T _____ R _____

3. Miscellaneous S _____ T _____ R _____
 Property in Sec. S _____ T _____ R _____

4. Lot No. _____, Recorded Plat _____

5. Private Claims _____

17370

Register of Deeds Stamp & File Number

I, Ralph W. VanRiper, in a field survey on June 4, 1993, do hereby certify that under requirements of P.A. 74, Michigan P.A. of 1970, the corner points mentioned in lines 1 and 2 above were in conformance with regulations and rules therefore as required in the current manual of survey instructions of the United States Department of the Interior, Bureau of Land Management or by a decree of a Court of Law and/or that the corner points mentioned in lines 3, 4 and 5 above were in conformance with the rules of the Michigan Board of Land Surveyors or by a Decree of a Court of Law; established, re-established, monumented, re-monumented, recovered, found as expressed below:

A	B	C	D	E	F	G	H	I	J	K	L	M
2	6	5	4	3	2	1						
3												
4	7	8	9	10	11	12						
5												
6	18	17	16	15	14	13						
7												
8	19	20	21	22	23	24						
9												
10	30	29	28	27	26	25						
11												
12	31	32	33	34	35	36						
13												

NOTE: Not more than 4 corners, all in the same town and range, may be recorded on this certificate.

A. Description of original monument and accessories and/or subsequent restoration:

1/4 Corner between Sections 26 and 35, T 11 N, R 16 W, Dalton Township

Post set June 21, 1837 by GLO Surveyors

Hemlock 18" S 18° E 17 L

B. Description of corner evidence found and/or method applied in restoring or reestablishing corner:


Found 1/2" Pipe inside of 2 1/2" Pipe as per NE 77.80' P. Pole
 Muskegon County Road Comm. Wittness Book NW 59.40' P. Pole
 SE 51.64' tw B. O.
 SW 51.85' 4" C.

Historical usage, documentation and evidence of NE 59.87' 10" Oak
 corner location reviewed and ratified by NW 54.43' 30" Poplar
 Muskegon County Peer Group, June 1, 1993

C. Description of monument for corner and accessories established to perpetuate locating the position of the corner:

Set 4" by 20" Cast Iron Monument with County Survey Cap

N 52° E 69.67' Set Spike in 6" Maple
 N 70° E 77.85' Set Spike in Power Pole
 S 43° E 51.88' Fd. Spike in Tw. 18" Oak
 S 33° W 46.93' Fd. Spike in Tel. Pole
 S 73° W 98.00' Set Spike in 14" Pine
 N 53° W 59.37' Fd. Spike in Guy Pole

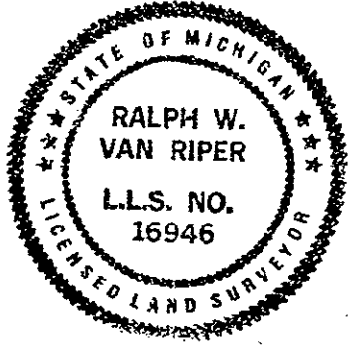

Signed by Ralph W. Van Riper Date Dec. 28, 1993
 Surveyor's Michigan License No. 16946