1993 LIBER 1744 PAGE 436

COMMISSION

LAND CORNER RECORDATION CERTIFICATE

Filing Requirement of Act 74, Mich. P.A. 1970

STATE OF MICHIGAN
COUNTY OF MUSKEGON
RECEIVED FOR RECORD
1993 DEC 29 PM 3:09
Carolyn Conklin
REGISTER OF DEEDS

For corners in Muskegon (County)

	Located In:	Corner Code //
1. Public Land Survey	T 11N R 16W	J 12
	T ___ R ___	
	T ___ R ___	
	T ___ R ___	
2. Property Controlling	S ___ T ___ R ___	
in Section	S ___ T ___ R ___	
3. Miscellaneous	S ___ T ___ R ___	
Property in Sec.	S ___ T ___ R ___	

Register of Deeds Stamp & File Number

4. Lot No. _____ , Recorded Plat _____
5. Private Claims _____

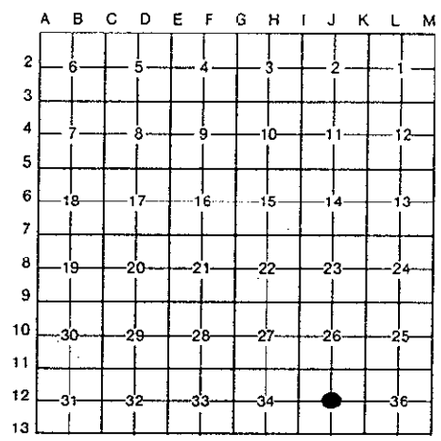

I, Ralph W. VanRiper, in a field survey on June 8, 19 93, do hereby certify that under requirements of P.A. 74, Michigan P.A. of 1970, the corner points mentioned in lines 1 and 2 above were in conformance with regulations and rules therefore as required in the current manual of survey instructions of the United States Department of the Interior, Bureau of Land Management or by a decree of a Court of Law and/or that the corner points mentioned in lines 3, 4 and 5 above were in conformance with the rules of the Michigan Board of Land Surveyors or by a Decree of a Court of Law; established, re-established, monumented, re-monumented, recovered, found as expressed below:

NOTE: Not more than 4 corners, all in the same town and range, may be recorded on this certificate.

A. Description of original monument and accessories and/or subsequent restoration:

Center of Section 35, T 11 N, R 16 W, Dalton Township

Not set by GLO Surveyors

B. Description of corner evidence found and/or method applied in restoring or reestablishing corner:

Found 1" Pinched Pipe
Recorded by Francis F. Smith, RLS No. 3538
Liber 1057, Page 146 - Feb. 17, 1975

SSW 90.30' Spike in Power Pole
SSE 78.30' Spike in Power Pole
East 33.10' 5/8" Iron Pipe

Historical usage, documentation and evidence of corner location reviewed and ratified by Muskegon County Peer Group, June 1, 1993

C. Description of monument for corner and accessories established to perpetuate locating the position of the corner:

Set 2 3/4" by 20" Cast Iron Monument with County Survey Cap

N 60° E 55.94' Fd. Spike in 16" Oak
S 87° E 33.38' Fd. 5/8" Iron Pipe
S 18° E 78.36' Fd. Spike in Power Pole
S 20° W 92.25' Fd. Spike in Power Pole
N 57° W 32.26' Set Spike in 10" Oak
N 14° W 76.78' Set Spike in 10" Oak

STATE OF MICHIGAN
RALPH W. VAN RIPER
L.L.S. NO. 16946
LICENSED LAND SURVEYOR

Signed by Ralph W. Van Riper Date Dec. 28, 1993

Surveyor's Michigan License No. 16946

FORM APPROVED BY MICHIGAN STATE BOARD OF LAND SURVEYORS, JAN. 28, 1971
REVISED MAY 14, 1975
REVISED JAN., 1983