

**SURVEY &  
REMONUMENTATION**

**LIBER 1810 PAGE 579**

**APR 28 1995**

STATE OF MICHIGAN  
COUNTY OF MUSKEGON  
RECEIVED FOR RECORD

1994 DEC 29 AM 10:14

**COMMISSION**

**LAND CORNER RECORDATION CERTIFICATE  
Filing Requirement of Act 74, Mich. P.A. 1970**

*Carrie Carter*  
REGISTER OF DEEDS

For corners in

<u>Muskegon</u> (County)	Located In:	Corner Code #
1. Public Land Survey	T <u>11</u> R <u>16</u>	<u>J-13</u>
	T _____ R _____	_____
	T _____ R _____	_____
	T _____ R _____	_____
2. Property Controlling in Section	S _____ T _____ R _____	_____
	S _____ T _____ R _____	_____
3. Miscellaneous Property in Sec.	S _____ T _____ R _____	_____
	S _____ T _____ R _____	_____

*A 1603*

Register of Deeds Stamp & File Number

4. Lot No. \_\_\_\_\_, Recorded Plat \_\_\_\_\_  
5. Private Claims \_\_\_\_\_

I, Stephen V. Vallier, in a field survey on December, 19 94, do hereby certify that under requirements of P.A. 74, Michigan P.A. of 1970, the corner points mentioned in lines 1 and 2 above were in conformance with regulations and rules therefore as required in the current manual of survey instructions of the United States Department of the Interior, Bureau of Land Management or by a decree of a Court of Law and/or that the corner points mentioned in lines 3, 4 and 5 above were in conformance with the rules of the Michigan Board of Land Surveyors or by a Decree of a Court of Law, established, re-established, monumented, re-monumented, recovered, found as expressed below:

	A	B	C	D	E	F	G	H	I	J	K	L	M
2	6	5	4	3	2	1							
3													
4	7	8	9	10	11	12							
5													
6	18	17	16	15	14	13							
7													
8	19	20	21	22	23	24							
9													
10	30	29	28	27	26	25							
11													
12	31	32	33	34	35	36							
13													


**NOTE: Not more than 4 corners, all in the same town and range, may be recorded on this certificate.**

A. Description of original monument and accessories and/or subsequent restoration:

- 1837 GLO set corner
- 1950's M.C.R.C. Tie Map - Witnesses only
- 1955 Record Plat of Eklund Subdivision
- 1976 L.C.R.C. Liber 1052 Page 465 - 1" Iron Rod
- 1982 C.F. Lewandowski - L.C.R.C. Liber 1237 Page 433 - Found 1" solid iron on top 1 1/2" iron pipe. Reset with 4" x 30" cast iron monument with County Survey Cap.

B. Description of corner evidence found and/or method applied in restoring or reestablishing corner:

Found 4" Cast Iron Monument with County Survey Cap.  
Accepted position of corner due to evidence of Historical usage and consistent documentation.

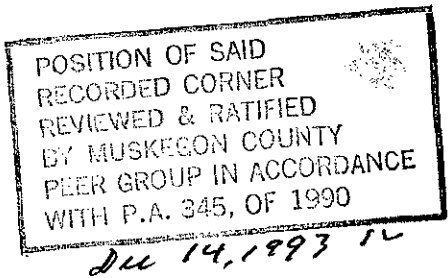

C. Description of monument for corner and accessories established to perpetuate locating the position of the corner:

- 4" Cast Iron Monument with County Survey Cap.
- N 48 deg E 41.05' Utility Pole with nail
  - N 26 deg W 40.70' 14" Tri Oak with nail
  - S 58 deg W 71.85' Telephone Pole with nail
  - S 58 deg E 33.56' Telephone Pole with nail
  - N 44 deg W 46.09' Concrete Monument.



Signed by *Stephen Vallier* Date *Dec 27, 1994*  
Surveyor's Michigan License No. 28428