

SURVEY & REMONUMENTATION

APR 28 1995

LIBER 1810 PAGE 615

STATE OF MICHIGAN
COUNTY OF MUSKEGON
RECEIVED FOR RECORD

COMMISSION

LAND CORNER RECORDATION CERTIFICATE 1994 DEC 29 AM 10:17
Filing Requirement of Act 74, Mich. P.A. 1970

For corners in

<u>Muskegon</u> (County)	Located In:	Corner Code #
1. Public Land Survey	T <u>11</u> R <u>16</u>	<u>K-1</u>
	T _____ R _____	_____
	T _____ R _____	_____
	T _____ R _____	_____
2. Property Controlling in Section	S _____ T _____ R _____	_____
	S _____ T _____ R _____	_____
3. Miscellaneous Property in Sec.	S _____ T _____ R _____	_____
	S _____ T _____ R _____	_____
4. Lot No. _____, Recorded Plat _____		
5. Private Claims _____		

Carris Carter
REGISTER OF DEEDS

A1639

Register of Deeds Stamp & File Number

Stephen V. Vallier, in a field survey on August 15, 1994, do hereby certify that under requirements of P.A. 74, Michigan P.A. of 1970, the corner points mentioned in lines 1 and 2 above were in conformance with regulations and rules therefore as required in the current manual of survey instructions of the United States Department of the Interior, Bureau of Land Management or by a decree of a Court of Law and/or that the corner points mentioned in lines 3, 4 and 5 above were in conformance with the rules of the Michigan Board of Land Surveyors or by a Decree of a Court of Law; established, re-established, monumented, re-monumented, recovered, found as expressed below:

NOTE: Not more than 4 corners, all in the same town and range, may be recorded on this certificate.

	A	B	C	D	E	F	G	H	I	J	K	L	M
2	6		5		4		3		2		1		
3													
4	7		8		9		10		11		12		
5													
6	18		17		16		15		14		13		
7													
8	19		20		21		22		23		24		
9													
10	30		29		28		27		26		25		
11													
12	31		32		33		34		35		36		
13													

A. Description of original monument and accessories and/or subsequent restoration:

- 1837 GLO set corner
- 1950's M.C.R.C. Tie map - 1" iron map
- 1984 C.F. Lewandowski - L.C.R.C. Liber 1242 page 298 - Found iron. Reset with 4" cast iron monument with County Survey Cap.

B. Description of corner evidence found and/or method applied in restoring or reestablishing corner:


Found 4" cast iron monument with County Survey Cap.
Accepted position of corner due to Historical usage and consistent documentation.

POSITION OF SAID
RECORDED CORNER
REVIEWED & RATIFIED
BY MUSKEGON COUNTY
PEER GROUP IN ACCORDANCE
WITH P.A. 345, OF 1990

Nov 8 1994 *JA*

C. Description of monument for corner and accessories established to perpetuate locating the position of the corner:
4" cast iron monument with County survey Cap.

- E 9.90' Iron Southeast corner Section 35 T10N R15W
- S 50 deg E 73.98' 10" Pine with nail
- S 68 deg W 33.64' 6" Poplar with nail

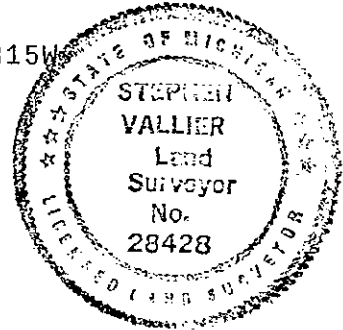

Signed by *Stephen Vallier*
Surveyor's Michigan License No. 28428

Date *Jan 27, 1994*