

**SURVEY &
REMONUMENTATION**

LIBER **1810** PAGE **647**

STATE OF MICHIGAN
COUNTY OF MUSKEGON
RECEIVED FOR RECORD

APR 28 1995

LAND CORNER RECORDATION CERTIFICATE
Filing Requirement of Act 74, Mich. P.A. 1970

1994 DEC 29 AM 10:20

For corners **COMMISSION**

Carrie Carter
REGISTER OF DEEDS

Muskegon (County)	Located In:	Corner Code =#
1. Public Land Survey	T <u>11N</u> R <u>16W</u>	<u>K 6</u>
	T _____ R _____	_____
	T _____ R _____	_____
	T _____ R _____	_____
2. Property Controlling in Section	S _____ T _____ R _____	_____
	S _____ T _____ R _____	_____
3. Miscellaneous Property in Sec.	S _____ T _____ R _____	_____
	S _____ T _____ R _____	_____

A1671

Register of Deeds Stamp & File Number

4. Lot No. _____, Recorded Plat _____
5. Private Claims _____

	A	B	C	D	E	F	G	H	I	J	K	L	M
2	6	5	4	3	2	1							
3													
4	7	8	9	10	11	12							
5													
6	18	17	16	15	14	13							
7													
8	19	20	21	22	23	24							
9													
10	30	29	28	27	26	25							
11													
12	31	32	33	34	35	36							
13													

I, Ralph W. VanRiper, in a field survey on December 8, 1994, do hereby certify that under requirements of P.A. 74, Michigan P.A. of 1970, the corner points mentioned in lines 1 and 2 above were in conformance with regulations and rules therefore as required in the current manual of survey instructions of the United States Department of the Interior, Bureau of Land Management or by a decree of a Court of Law and/or that the corner points mentioned in lines 3, 4 and 5 above were in conformance with the rules of the Michigan Board of Land Surveyors or by a Decree of a Court of Law; established, re-established, monumented, re-monumented, recovered, found as expressed below:

NOTE: Not more than 4 corners, all in the same town and range, may be recorded on this certificate.

A. Description of original monument and accessories and/or subsequent restoration:

1/4 corner between Sections 13 and 14, T 11 N, R 16 W, Dalton Township.

Set post June 20, 1837, by GLO Surveyors

B. Ash 7" N 28° E 12 L
Maple 10" N 23° W 15 L

B. Description of corner evidence found and/or method applied in restoring or reestablishing corner:

Found 1/2" rod as per Muskegon County Road Commission Witness book, recorded by David E. Erickson, LLS #29245, Liber 1659, Page 334, November 6, 1992.

N 82° E 20.22' Nail in S side 10" Quad Maple
S 58° E 11.39' Nail in SW side 8" Maple
S 13° W 48.16' Nail in E side 12" Oak
N 55° W 17.58' 3/8" rebar on W bank of ditch


POSITION OF SAID
RECORDED CORNER
REVIEWED & SATISFIED
BY MUSKEGON COUNTY
PEER GROUP IN ACCORDANCE
WITH P.A. 345, OF 1990

May 2 1994

C. Description of monument for corner and accessories established to perpetuate locating the position of the corner:

Set 2 3/4" Cast Iron Monument with County Surveyor Cap.

N 15° W 13.31' Set nail E side 4" Oak
S 82° E 20.21' Fd. nail S side Quad Maple
S 58° E 11.40' Fd. nail SW side 10" maple
S 10° E 22.30' Set nail SW side 4" maple
S 0°5' E 49.37' Set nail SW side 4" Maple
S 13° W 48.18' Fd. nail E side 14" Oak

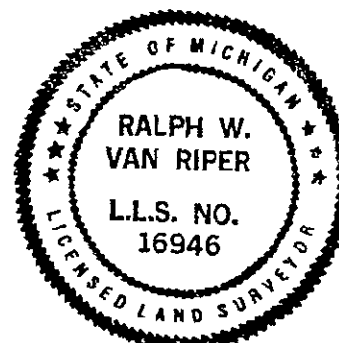

Signed by *Ralph W. Van Riper* Date 12/27/94
Surveyor's Michigan License No. 16946