

**SURVEY &
REMONUMENTATION**

LIBER **1810** PAGE **619**

STATE OF MICHIGAN
COUNTY OF MUSKEGON
RECEIVED FOR RECORD

APR 28 1995

1994 DEC 29 AM 10:17

COMMISSION

LAND CORNER RECORDATION CERTIFICATE
Filing Requirement of Act 74, Mich. P.A. 1970

Carris Carter
REGISTER OF DEEDS

For corners in

<u>Muskegon</u> <small>(County)</small>	Located In:	Corner Code #
1. Public Land Survey	T <u>11</u> R <u>16</u>	<u>L-1</u>
	T _____ R _____	_____
	T _____ R _____	_____
	T _____ R _____	_____
2. Property Controlling in Section	S _____ T _____ R _____	_____
	S _____ T _____ R _____	_____
3. Miscellaneous Property in Sec.	S _____ T _____ R _____	_____
	S _____ T _____ R _____	_____

A1643

Register of Deeds Stamp & File Number

4. Lot No. _____, Recorded Plat _____
5. Private Claims _____

	A	B	C	D	E	F	G	H	I	J	K	L	M
2	6	5	4	3	2	1							
3													
4	7	8	9	10	11	12							
5													
6	18	17	16	15	14	13							
7													
8	19	20	21	22	23	24							
9													
10	30	29	28	27	26	25							
11													
12	31	32	33	34	35	36							
13													

I, Stephen V. Vallier, a field surveyor on December, 19 94, do hereby certify that under requirements of P.A. 74, Michigan P.A. of 1970, the corner points mentioned in lines 1 and 2 above were in conformance with regulations and rules therefore as required in the current manual of survey instructions of the United States Department of the Interior, Bureau of Land Management or by a decree of a Court of Law and/or that the corner points mentioned in lines 3, 4 and 5 above were in conformance with the rules of the Michigan Board of Land Surveyors or by a Decree of a Court of Law; established, re-established, monumented, re-monumented, recovered, found as expressed below:

NOTE: Not more than 4 corners, all in the same town and range, may be recorded on this certificate.

A. Description of original monument and accessories and/or subsequent restoration:

- 1837 GLO set corner
- 1950's M.C.R.C. Tie Map Iron
- 1980 D. Schiele L.C.R.C. Liber 1188 Page 678 - Found steel box
- 1983 C.F. Lewandowski L.C.R.C. Liber 1271 Page 934 - Found capped iron. Reset 4" x 30" cast iron monument with County Survey Cap.

B. Description of corner evidence found and/or method applied in restoring or reestablishing corner:


Found 4" cast iron monument with County Survey Cap.
Accepted position of corner due to Historical usage and consistent documentation.

POSITION OF SAID
RECORDED CORNER
REVIEWED & RATIFIED
BY MUSKEGON COUNTY
FIELD GROUP IN ACCORDANCE
WITH P.A. 345, OF 1990
N.V. 11 1199

C. Description of monument for corner and accessories established to perpetuate locating the position of the corner:

4" Cast Iron monument with County Survey Cap.

- W 41.27' South 1/4 Post Section 36 T12N R16@
- N 27.25' 6" Pine with nail
- S 7U deg E 22.13' 10" Twin Oak with nail
- W 26.18' 14" Oak
- W 53.80' P.K. centerline road

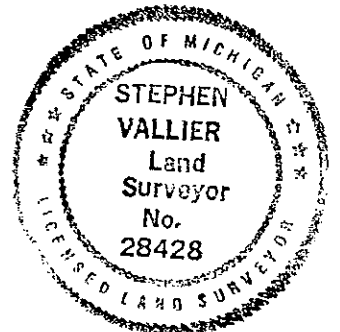

Signed by *Stephen Vallier* Date *Dec 27, 1994*

Surveyor's Michigan License No. 28428