

APR 28 1995

1994 DEC 29 AM 10:20

COMMISSION

LAND CORNER RECORDATION CERTIFICATE
Filing Requirement of Act 74, Mich. P.A. 1970

Carrie Carter
REGISTER OF DEEDS

For corners in

Muskegon (County)	Located In:	Corner Code ##
1. Public Land Survey	T <u>11N</u> R <u>16W</u>	<u>L 2</u>
	T _____ R _____	_____
	T _____ R _____	_____
	T _____ R _____	_____
2. Property Controlling in Section	S _____ T _____ R _____	_____
	S _____ T _____ R _____	_____
3. Miscellaneous Property in Sec.	S _____ T _____ R _____	_____
	S _____ T _____ R _____	_____

A1672

Register of Deeds Stamp & File Number

4. Lot No. _____, Recorded Plat _____
5. Private Claims _____

	A	B	C	D	E	F	G	H	I	J	K	L	M
2	6	5	4	3	2								
3													
4	7	8	9	10	11	12							
5													
6	18	17	16	15	14	13							
7													
8	19	20	21	22	23	24							
9													
10	30	29	28	27	26	25							
11													
12	31	32	33	34	35	36							
13													

I, Ralph W. VanRiper, in a field survey on May 18, 19 94, do hereby certify that under requirements of P.A. 74, Michigan P.A. of 1970, the corner points mentioned in lines 1 and 2 above were in conformance with regulations and rules therefore as required in the current manual of survey instructions of the United States Department of the Interior, Bureau of Land Management or by a decree of a Court of Law and/or that the corner points mentioned in lines 3, 4 and 5 above were in conformance with the rules of the Michigan Board of Land Surveyors or by a Decree of a Court of Law; established, re-established, monumented, re-monumented, recovered, found as expressed below:

NOTE: Not more than 4 corners, all in the same town and range, may be recorded on this certificate.

A. Description of original monument and accessories and/or subsequent restoration:


Center of Section 1, T 11 N, R 16 W, Dalton Township.

Not set by GLO Surveyors

B. Description of corner evidence found and/or method applied in restoring or reestablishing corner:

Found 1 1/2" pipe as per Muskegon County Road Commission Witness book. Recorded by Donald W. Schiele, RLS #23517, Liber 1188, Page 677, February 6, 1980.

Power Pole	NE	60.02'
20" Oak	SE	56.33'
Power Pole	SW	40.68'
30" Oak	NW	50.52'

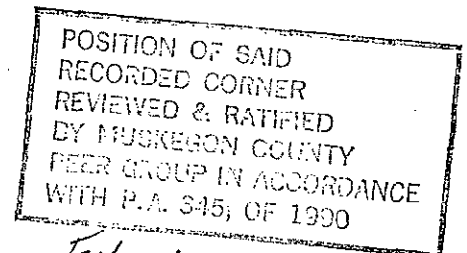

Feb 1, 1994 SW

C. Description of monument for corner and accessories established to perpetuate locating the position of the corner:

Set 4" Cast Iron Monument with County Surveyor Cap.

N 40° W	50.55'	Fd. nail NW side	26" Oak
N 60° W	68.45'	Fd. nail NE side	20" Oak
S 40° W	40.76'	Fd. nail NW side	Power Pole
S 20° E	58.97'	Fd. nail SW side	Guy Pole
S 45° E	66.34'	Fd. nail SW side	18" Oak
N 45° E	60.01'	Fd. nail SE side	Power Pole



Signed by *Ralph W. Van Riper*

Date 12/27/94

Surveyor's Michigan License No. 16946