

changed 1810 p.620

re-recorded to

LIBER 1853 PAGE 884

STATE OF MICHIGAN
COUNTY OF MUSKEGON
REGISTERED RECORD

1995 SEP 18 AM 10:09

LAND CORNER RECORDATION CERTIFICATE
Filing Requirement of Act 74, Mich. P.A. 1970

Stephen Vallier
REGISTERED SURVEYORS

corners in

MUSKEGON
(County)

Located In:

Corner Code #1

Public Land Survey

T 11N R 16W

L-7

SURVEY &
REMONUMENTATION

Property Controlling
in Section

S T R

Miscellaneous

S T R

Property in Sec.

S T R

APR 04 1996

COMMISSION

Register of Deeds Stamp & File Number

Lot No. _____, Recorded Plat _____

Private Claims _____

STEPHEN V. VALLIER in a field survey on DECEMBER 19 94

whereby certify that under requirements of P.A. 74, Michigan P.A. of 1970, the corner points mentioned in lines 1 and 2 above were in conformance with regulations and rules therefore as required in the present manual of survey instructions of the United States Department of the Interior, Bureau of Land Management or by a decree of a Court of Law and/or that the corner points mentioned in lines 3, 4 and 5 were in conformance with the rules of the Michigan Board of Land Surveyors or by a Decree of a Court of Law; established, re-established, monumented, re-monumented, recovered, found as listed below:

Note: Not more than 4 corners, all in the same town and range, may be recorded on this certificate.

Description of original monument and accessories and/or subsequent restoration:

- 837 GLO SET CORNER
- 950'S M.C.R.C. TIE MAP
- 979 D. SCHIELE - L.C.R.C. LIBER 1255 PAGE 473. CAPPED IRON
- 982 C.F. LEWANDOWSKI - LIBER 1301 PAGE 589. FOUND IRON IN MONUMENT BOX.


	A	B	C	D	E	F	G	H	I	J	K	L	M
2	6	5	4	3	2	1							
3													
4	7	8	9	10	11	12							
5													
6	18	17	16	15	14	13							
7													
8	19	20	21	22	23	24							
9													
10	30	29	28	27	26	25							
11													
12	31	32	33	34	35	36							
13													

Description of corner evidence found and/or method applied in restoring or reestablishing corner:

FOUND IRON BOLT IN CONCRETE IN MONUMENT BOX. ACCEPTED POSITION OF CORNER REFERENCE TO HISTORICAL USAGE AND CONSISTENT DOCUMENTATION.

Description of monument for corner and accessories established to perpetuate locating the position of the corner:

- IRON BOLT IN MONUMENT BOX (IN CONCRETE) WITH 2" COUNTY SURVEY CAP
- 20 DEG E 28.48' RIVET IN SOUTH END C.M.P.
- 20 DEG E 30.77' RIVET IN NORTH END C.M.P.
- 70 DEG W 102.15' 18" PINE WITH NAIL
- 75 DEG E 234.74' POWER POLE WITH NAIL

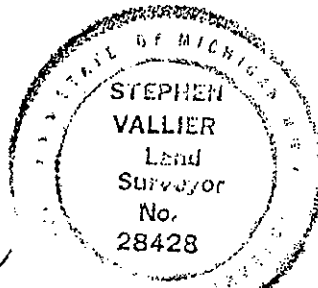

by *Stephen Vallier*
Surveyor's Michigan License No. 28428

Date *Sept 15, 1995*