

LAND CORNER RECORDATION CERTIFICATE
 Filing Requirement of Act 74, Mich. P.A. 1970

STATE OF MICHIGAN
 COUNTY OF MUSKEGON

For corners in Muskegon County

Located in: Corner Code #

1. Public Land Survey T 11N R 16W B-1 *sq #2*
 T _____ R _____
 T _____ R _____
 T _____ R _____

2. Property Controlling in Section S _____ T _____ R _____
 S _____ T _____ R _____

3. Miscellaneous Property in Sec. S _____ T _____ R _____
 S _____ T _____ R _____

4. Lot No _____, Recorded Plat _____

5. Private Claims _____

A01705 1996 DEC 23 AM 10:15

Commissioner
 REGISTER OF DEEDS

Register of Deeds Stamp & File Number

I, Donald G. Sandel, in a field survey on Nov. 27, 1996 hereby certify that under requirements of P.A. 74, Michigan P.A. of 1970, the corner points mentioned in lines 1 and 2 above were in conformance with regulations and rules therefore as required in the current manual of survey instructions of the United States Department of the Interior, Bureau of Land Management or by a decree of a Court of Law and/or that the corner points mentioned in lines 3, 4 and 5 above were in conformance with the rules of the Michigan Board of Land Surveyors or by a Decree of a Court of Law; established, re-established, monumented, re-monumented, recovered, found as expressed below:

A	B	C	D	E	F	G	H	I	J	K	L	M
	6	5	4	3	2	1						
2												
3												
4	7	6	5	4	3	2	1					
5												
6	18	17	16	15	14	13						
7												
8	19	18	17	16	15	14	13	12	11	10	9	8
9												
10	30	29	28	27	26	25						
11												
12	31	30	29	28	27	26	25	24	23	22	21	20
13												

SURVEY & REMONUMENTATION

MAR 21 1997

COMMISSION

NOTE: Not more than 4 corners, all in the same town and range, may be recorded on this certificate.

A. Description of original monument and accessories and/or subsequent restoration:

- (1) Quarter section not set by GLO.
- (2) Muskegon County Road Commission (1950's): no witnesses found on record.
- (3) Corner referenced to plat of Lakewood Addition Number 5, platted by Albert Peck, March 1912.

B. Description of corner evidence found and/or method applied in restoring or reestablishing corner:


- (1) Found 1" pipe at centerline of White Lake Drive, verified corner location using existing witnesses.
- (2) Historical usage, documentation, and evidence of corner location reviewed and ratified by the Muskegon County Peer Group, March 7, 1995.

THIS CERTIFICATE SUPERSEDES LIBER 1870, PAGE 68 WHICH WAS RECORDED IN ERROR.

C. Description of monument for corner and accessories established to perpetuate locating the position of the corner:

Set 3" X 30" Cast Iron "County Survey" monument in place of found 1" pipe; 184.75' E of Quarter Section monument B-13 of T12N, R16W; witnessed as follows:
 N20°W, set nail NE side 14" Pine 52.84'
 N45°E, set nail NW side 10" Pine 56.58'
 S33°E, set nail W side 18" Oak 58.30'
 S25°E, set nail E side 18" Oak 37.15'
 S25°W, found 1" pipe 36.02'
 S52°W, set nail E side 14" Oak 49.19'

POSITION OF CORNER
 RECORDED CORNER
 REVIEWED & RATIFIED
 BY PEER GROUP
 MARCH 7, 1995

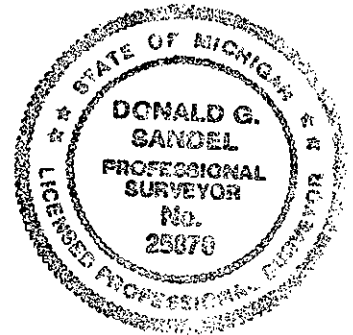

Signed by Donald G. Sandel
 Surveyor's Michigan License No. 25870

Date 19 December 1996