

SURVEY & REMONUMENTATION

L1871 Pg. 614

A1733

APR 04 1996

COMMISSION

LAND CORNER RECORDATION CERTIFICATE
Filing Requirement of Act 74, Mich. P.A. 1970

For corners in
Muskegon

	Located In:		Corner Code #
	11N	17W	
1. Public Land Survey	T ___ R ___	B-9	
	T ___ R ___		
	T ___ R ___		
	T ___ R ___		
2. Property Controlling in Section	S ___ T ___ R ___		
	S ___ T ___ R ___		
3. Miscellaneous Property in Sec.	S ___ T ___ R ___		
	S ___ T ___ R ___		

STATE OF MICHIGAN
 COUNTY OF MUSKEGON
 REGISTER OF DEEDS
 1995 NOV 10 PM 4:15

Register of Deeds Stamp & File Number

4. Lot No. _____, Recorded Plat _____
 5. Private Claims _____

A	B	C	D	E	F	G	H	I	J	K	L
2	6	5	4	3	2	1					
3											
4	7	8	9	10	11						
5											
6	18	17	16	15	14						
7											
8	19	20	21	22	23						
9											
10	30	29	28	27	26						
11											
12	31	32	33	34	35	36					
13											

I, Stephen V. Vallier, P.S., in a field survey on November 7, 1995, do hereby certify that under requirements of P.A. 74, Michigan P.A. of 1970, the corner points mentioned in lines 1 and 2 above were in conformance with regulations and rules therefore as required in the current manual of survey instructions of the United States Department of the Interior, Bureau of Land Management or by a decree of a Court of Law and/or that the corner points mentioned in lines 3, 4 and 5 above were in conformance with the rules of the Michigan Board of Land Surveyors or by a Decree of a Court of Law; established, re-established, monumented, re-monumented, recovered, found as expressed below:

NOTE: Not more than 4 corners, all in the same town and range, may be recorded on this certificate.

A. Description of original monument and accessories and/or subsequent restoration:

- 1837 GLO set corner 10" Maple at corner
- N 45 deg. E 1 Link 10" Maple
- 1943 M. Buck survey shows position of corner
- 1979 J. Campbell found 1" Iron. Recorded Liber 1171 Page 908
- WNW 31.60' 24" Cedar
- SSW 29.04' 12" Beech
- NNW 13.00' 14" Beech

(see Exhibit "A")

B. Description of corner evidence found and/or method applied in restoring or reestablishing corner:


Found 2 3/4" x 30" Cast Iron Monument with County Survey Cap. Checks position of 1943 M. Buck survey and witnesses of LCRC Liber 1480 Page 74.

POSITION OF SAID
 RECORDED CORNER
 REVIEWED & RATIFIED
 BY MUSKEGON COUNTY
 PEER GROUP IN ACCORDANCE
 WITH P.A. 345, OF 1990
Nov. 7, 1995

C. Description of monument for corner and accessories established to perpetuate locating the position of the corner:

Found 2 3/4" x 30" Cast Iron Monument with County Survey Cap.

- | | | |
|-------------|--------|---------------------------------|
| East | 10.00' | 30" Hemlock (nail with blaze) |
| S 24 deg. E | 7.91' | 14" Beech (nail with blaze) |
| S 15 deg. W | 34.76' | 14" White Oak (nail with blaze) |
| S 42 deg. W | 29.27' | 12" Beech (nail with blaze) |
| N 58 deg. W | 31.56' | 30" Hemlock (nail with blaze) |
| N 26 deg. W | 13.04' | 14" Beech (nail with blaze) |

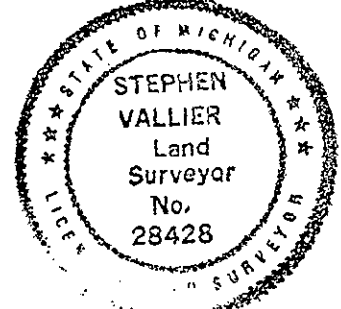

Signed by *Stephen V. Vallier* Date 12/15/95

Surveyor's Michigan License No. 28428