

LAND CORNER RECORDATION CERTIFICATE
Filing Requirement of Act 74, Mich. P.A. 1970

STATE OF MICHIGAN
COUNTY OF MUSKEGON
REGISTER OF DEEDS

For corners in
Muskegon County

Located in:

Corner Code #

- 1. Public Land Survey T 11N R 17W C-6
T _____ R _____
T _____ R _____
T _____ R _____
- 2. Property Controlling S _____ T _____ R _____
in Section S _____ T _____ R _____
- 3. Miscellaneous S _____ T _____ R _____
Property in Sec. S _____ T _____ R _____
- 4. Lot No _____, Recorded Plat _____
- 5. Private Claims _____

A 1783 1996 DEC 23 AM 10:14

Carris Carter
REGISTER OF DEEDS

Register of Deeds Stamp & File Number

I, Donald G. Sandel, in a field survey on Nov. 13, 1996 hereby certify that under requirements of P.A. 74, Michigan P.A. of 1970, the corner points mentioned in lines 1 and 2 above were in conformance with regulations and rules therefore as required in the current manual of survey instructions of the United States Department of the Interior, Bureau of Land Management or by a decree of a Court of Law and/or that the corner points mentioned in lines 3, 4 and 5 above were in conformance with the rules of the Michigan Board of Land Surveyors or by a Decree of a Court of Law; established, re-established, monumented, re-monumented, recovered, found as expressed below:

| | A | B | C | D | E | F | G | H | I | J | K | L | M |
|----|----|----|----|----|----|----|----|----|----|----|----|---|---|
| 2 | 6 | | 5 | | 4 | | 3 | | 2 | | 1 | | |
| 3 | | | | | | | | | | | | | |
| 4 | 7 | | 8 | | 9 | | 10 | | 11 | | 12 | | |
| 5 | | | | | | | | | | | | | |
| 6 | 18 | 17 | | 16 | | 15 | | 14 | | 13 | | | |
| 7 | | | | | | | | | | | | | |
| 8 | 19 | | 20 | | 21 | | 22 | | 23 | | 24 | | |
| 9 | | | | | | | | | | | | | |
| 10 | 30 | | 29 | | 28 | | 27 | | 26 | | 25 | | |
| 11 | | | | | | | | | | | | | |
| 12 | 31 | | 32 | | 33 | | 34 | | 35 | | 36 | | |
| 13 | | | | | | | | | | | | | |

NOTE: Not more than 4 corners, all in the same town and range, may be recorded on this certificate.

SURVEY &
REMONUMENTATION

MAR 21 1997

COMMISSION

A. Description of original monument and accessories and/or subsequent restoration:

- (1) GLO: Set quarter section post, July 6, 1837.
30" Pine N52 degrees W .34 chains

- (2) Muskegon County Road Commission (1950): Found 1" iron pipe: WNW 18" Pine 42.81', WNW 8" oak 38.30', ESE 20" Oak 33.55', NE 8: Oak 38.34', NW 12" Oak 61.45'


B. Description of corner evidence found and/or method applied in restoring or reestablishing corner:

- (1) Found 3/4" pipe in centerline of Nestrom Road, verified corner location using existing witnesses.
- (2) Historical usage, documentation, and evidence of corner location reviewed and ratified by the Muskegon County Peer Group, April 2, 1996.

C. Description of monument for corner and accessories established to perpetuate locating the position of the corner:

Set 3" X 30" Cast Iron "County Survey" monument in place of found 3/4 pipe; witnessed as follows:
 S88°E, found nail N side, Power Pole, 53.37'
 S30°E, set nail E side, 10" Oak, 45.08'
 S35°W, set nail W side, 12" Oak, 44.97'
 S78°W, found nail S side, 30" Oak, 33.60'
 N67°W, found nail S side, 26" Dead Pine, 42.84'
 N30°W, set nail NE side, 6" Pine, 54.84'

POSITION OF SAID
 RECORDED CORNER
 REVIEWED & RATIFIED
 BY MUSKEGON COUNTY
 PEER GROUP IN ACCORDANCE
 WITH P.A. 345, OF 1990

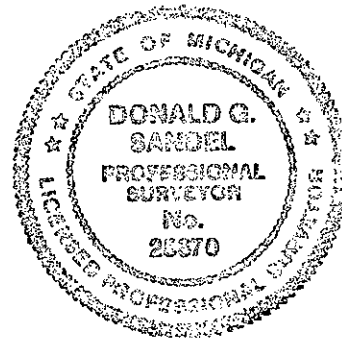

Signed by Donald G. Sandel
Surveyor's Michigan License No. 25870

Date 19 December 1996