

**SURVEY &
MONUMENTATION**

8187T Pg. 627-

A 1740

APR 04 1996

LAND CORNER RECORDATION CERTIFICATE
Filing Requirement of Act 74, Mich. P.A. 1970

For corners in **COMMISSION**


<u>Muskegon</u> (County)	Located In:	Corner Code #
1. Public Land Survey	T <u>11N</u> R <u>17W</u>	<u>D-11</u>
	T _____ R _____	_____
	T _____ R _____	_____
	T _____ R _____	_____
2. Property Controlling in Section	S _____ T _____ R _____	_____
	S _____ T _____ R _____	_____
3. Miscellaneous Property in Sec.	S _____ T _____ R _____	_____
	S _____ T _____ R _____	_____
4. Lot No. _____, Recorded Plat _____		
5. Private Claims _____		

STATE OF MICHIGAN
COUNTY OF MUSKEGON
REGISTER OF DEEDS

1995 OCT 18 PM 4:16

Register of Deeds Stamp & File Number

I, Stephen V. Vallier, P.S., in a field survey on November 6, 1995, do hereby certify that under requirements of P.A. 74, Michigan P.A. of 1970, the corner points mentioned in lines 1 and 2 above were in conformance with regulations and rules therefore as required in the current manual of survey instructions of the United States Department of the Interior, Bureau of Land Management or by a decree of a Court of Law and/or that the corner points mentioned in lines 3, 4 and 5 above were in conformance with the rules of the Michigan Board of Land Surveyors or by a Decree of a Court of Law; established, re-established, monumented, re-monumented, recovered, found as expressed below:

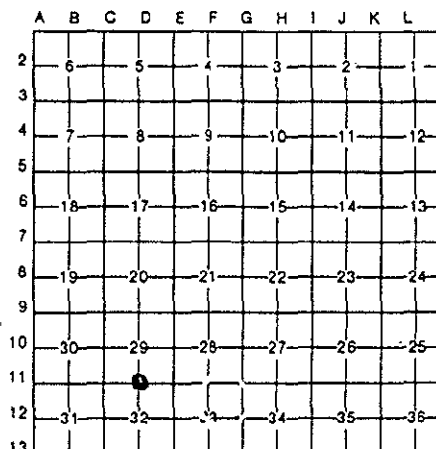

NOTE: Not more than 4 corners, all in the same town and range, may be recorded on this certificate.

A. Description of original monument and accessories and/or subsequent restoration:

1837 GLO set corner
1982 F. Lewandowski found Bolt. Reset with 4" x 30" Cast Iron Monument with County Survey Cap.

- N 50 deg. W 41.50' 24" Oak
 - S 50 deg. W 51.84' 16" Oak
 - S 50 deg. E 65.45' Oak
 - N 60 deg. E 89.82' 10" Pine
- (see Exhibit "A")

B. Description of corner evidence found and/or method applied in restoring or reestablishing corner:

Found 4" x 30" Cast Iron Monument with County Survey Cap. Checks witnesses from Section "A".

POSITION OF SAID
RECORDED CORNER
REVIEWED & RATIFIED
BY MUSKEGON COUNTY
PEER GROUP IN ACCORDANCE
WITH P.A. 345, OF 1990

Nov. 13, 1995

C. Description of monument for corner and accessories established to perpetuate locating the position of the corner:
Found 4" x 30" Cast Iron Monument with County survey Cap.

- S 41 deg. E 60.79' 10" White Oak
- S 28.76' Power Pole
- S 22 deg. W 46.39' 12" Oak
- N 29 deg. E 54.41' 12" Oak
- N 31 deg. W 55.91' 10" Oak
- N 60 deg. E 89.82' 10" Pine



Signed by Stephen V. Vallier Date Nov 13, 1995
Surveyor's Michigan License No. 28428