

LAND CORNER RECORDATION CERTIFICATE
Filing Requirement of Act 74, Mich. P.A. 1970

STATE OF MICHIGAN
COUNTY OF MUSKEGON
REGISTER OF DEEDS

For corners in
Muskegon County

Located in: Corner Code #

A01730

MAR 23 AM 10:15

- 1. Public Land Survey T 11N R 17W E-1
T _____ R _____
T _____ R _____
T _____ R _____
- 2. Property Controlling S _____ T _____ R _____
in Section S _____ T _____ R _____
- 3. Miscellaneous S _____ T _____ R _____
Property in Sec. S _____ T _____ R _____
- 4. Lot No _____, Recorded Plat _____
- 5. Private Claims _____

Carroll Carter
REGISTER OF DEEDS

Register of Deeds Stamp & File Number

	A	B	C	D	E	F	G	H	I	J	K	L	M
2	6		5		4		3		2		1		
3													
4	7		8		9		10		11		12		
5													
6	18		17		16		15		14		13		
7													
8	19		20		21		22		23		24		
9													
10	30		29		28		27		26		25		
11													
12	31		32		33		34		35		36		
13													

I, Donald G. Sandel, in a field survey on Nov. 20, 1996 hereby certify that under requirements of P.A. 74, Michigan P.A. of 1970, the corner points mentioned in lines 1 and 2 above were in conformance with regulations and rules therefore as required in the current manual of survey instructions of the United States Department of the Interior, Bureau of Land Management or by a decree of a Court of Law and/or that the corner points mentioned in lines 3, 4 and 5 above were in conformance with the rules of the Michigan Board of Land Surveyors or by a Decree of a Court of Law; established, re-established, monumented, re-monumented, recovered, found as expressed below:

NOTE: Not more than 4 corners, all in the same town and range, may be recorded on this certificate.

SURVEY &
REMONUMENTATION


MAR 21 1997

COMMISSION

A. Description of original monument and accessories and/or subsequent restoration:

- (1) GLO: Set corner post, May 14, 1837.
12" Beech N36 degrees E .12 chains
10" Beech N75 degrees W .34 chains

- (2) March 19, 1981, Found PK Nail, D. Sandel, #25870, replaced with "T" iron, witnessed :
Fencepost N29 degrees E 37.15',
60" Stump S15 degrees W 64.00',
Fencepost N53 degrees W 58.28',
24" W. Cherry N05 degrees W 33.50'

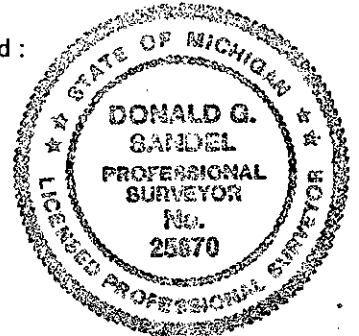

- (3) Found "T" iron - D. Sandel, #25870, July 20, 1994 and witnessed as follows:
Fencepost N29 degrees E 37.15'
Fencepost N53 degrees W 58.28'
24" Cherry N05 degrees W 33.50'

B. Description of corner evidence found and/or method applied in restoring or reestablishing corner:

- (1) Found "T" iron in monument box at centerline of White Lake Drive, verified corner location using existing witnesses.
- (2) Historical usage, documentation, and evidence of corner location reviewed and ratified by the Muskegon County Peer Group, March 5, 1996.

C. Description of monument for corner and accessories established to perpetuate locating the position of the corner:

- Set 3" X 30" Cast Iron "County Survey" monument in place of found "T" iron; witnessed as follows:
N04°W, found nail E side, 26" W. Cherry, 33.49'
N24°E, set nail E side, 8" Maple, 27.77'
N52°E, set nail NW side, 8" Maple, 35.78'
N55°E, set nail SE side, 6" Maple, 45.19'
S58°E, set N edge speed limit sign, 44.35'
S68°W, set N edge Do Not Pass Sign, 51.35'

POSITION OF SAID
RECORDED CORNER
REVIEWED & RATIFIED
BY MUSKEGON COUNTY
PEER GROUP IN ACCORDANCE
WITH P.A. 315, OF 1990

Signed by Donald G. Sandel
Surveyor's Michigan License No. 25870

Date 19 December 1996