

LAND CORNER RECORDATION CERTIFICATE  
Filing Requirement of Act 74, Mich. P.A. 1970

For corners in Muskegon County Located in: Corner Code #

1. Public Land Survey T 11N R 17W E-2  
 T \_\_\_\_\_ R \_\_\_\_\_  
 T \_\_\_\_\_ R \_\_\_\_\_  
 T \_\_\_\_\_ R \_\_\_\_\_

2. Property Controlling S \_\_\_\_\_ T \_\_\_\_\_ R \_\_\_\_\_  
 in Section S \_\_\_\_\_ T \_\_\_\_\_ R \_\_\_\_\_

3. Miscellaneous S \_\_\_\_\_ T \_\_\_\_\_ R \_\_\_\_\_  
 Property in Sec. S \_\_\_\_\_ T \_\_\_\_\_ R \_\_\_\_\_

4. Lot No \_\_\_\_\_, Recorded Plat \_\_\_\_\_

5. Private Claims \_\_\_\_\_

APR 14 1996 10:23 AM 14  
*Carroll*  
 REGISTER OF DEEDS

Register of Deeds Stamp & File Number

	A	B	C	D	E	F	G	H	I	J	K	L	M
2	6	5	4	3	2	1							
3													
4	7	8	9	10	11	12							
5													
6	18	17	16	15	14	13							
7													
8	19	20	21	22	23	24							
9													
10	30	29	28	27	26	25							
11													
12	31	32	33	34	35	36							
13													

I, Donald G. Sandel, in a field survey on Nov. 19, 1996 hereby certify that under requirements of P.A. 74, Michigan P.A. of 1970, the corner points mentioned in lines 1 and 2 above were in conformance with regulations and rules therefore as required in the current manual of survey instructions of the United States Department of the Interior, Bureau of Land Management or by a decree of a Court of Law and/or that the corner points mentioned in lines 3, 4 and 5 above were in conformance with the rules of the Michigan Board of Land Surveyors or by a Decree of a Court of Law; established, re-established, monumented, re-monumented, recovered, found as expressed below:

NOTE: Not more than 4 corners, all in the same town and range, may be recorded on this certificate.

SURVEY & REMONUMENTATION

MAR 21 1997

COMMISSION


A. Description of original monument and accessories and/or subsequent restoration:

- (1) GLO: Set Quarter post, July 4, 1837.  
6" Beech S66 degrees W .20 chains  
9" Beech N48 degrees E .08 chains

- (2) Muskegon County Road Commission (1950's) witnesses: 20" Oak ENE 38.2', 10" Oak W 39.0'.

- (3) West 1/4 corner, Section 4, found 1" square iron, D. Sandel, #25870 on June 8, 1981:  
8" B. Oak S60 degrees W 47.28',  
14" B. Oak S60 degrees W 55.38',  
18" B. Oak N68 degrees W 13.45',  
16" Oak N63 degrees W 46.94'

- (4) Found 1" square iron - D. Sandel, #25870, E 1/4 corner, Section 5, August 10, 1995.  
10" Oak N54 degrees W 13.50'  
8" Oak S57 degrees W 47.35'  
8" Oak N71 degrees E 20.40'  
6" Poplar S25 degrees E 24.69'

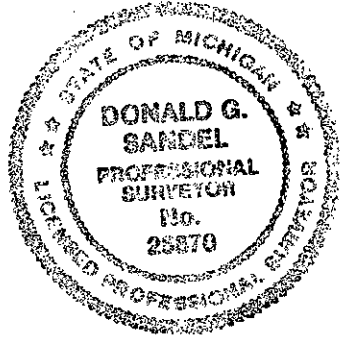


B. Description of corner evidence found and/or method applied in restoring or reestablishing corner:

- (1) Found 1 1/4" X 24" square iron, verified corner location using existing witnesses.
- (2) Historical usage, documentation, and evidence of corner location reviewed and ratified by the Muskegon County Peer Group, March 5, 1996.

C. Description of monument for corner and accessories established to perpetuate locating the position of the corner:

Set 3" X 30" Cast Iron "County Survey" monument in place of found 1 1/4" pipe; witnessed as follows:  
 N68°W, found nail N side, 14" Pine, 13.56'  
 N05°W, found nail SW side, 42" Cherry, 67.87'  
 N67°E, set nail NW side, 14" Oak, 20.30'  
 S27°E, found nail E side, 10" Poplar, 24.67'  
 S48°W, found nail E side, 12" Poplar, 30.72'  
 S61°W, found nail NW side, 16" Oak, 47.40'

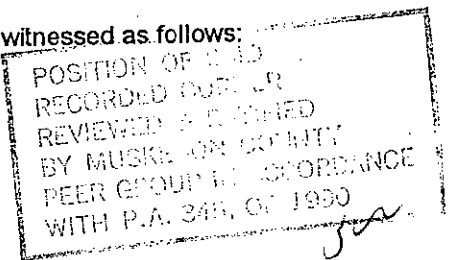

Signed by Donald G. Sandel Date 19 December 1996  
 Surveyor's Michigan License No. 25870