

L1871 Pg. 608

A1730

LAND CORNER RECORDATION CERTIFICATE  
Filing Requirement of Act 74, Mich. P.A. 1970

For corners in

Muskegon (County) Located In: Corner Code #

1. Public Land Survey T 11N R 17W E-5  
 T \_\_\_ R \_\_\_  
 T \_\_\_ R \_\_\_  
 T \_\_\_ R \_\_\_

2. Property Controlling S \_\_\_ T \_\_\_ R \_\_\_  
 in Section S \_\_\_ T \_\_\_ R \_\_\_

3. Miscellaneous S \_\_\_ T \_\_\_ R \_\_\_  
 Property in Sec. S \_\_\_ T \_\_\_ R \_\_\_

4. Lot No. \_\_\_\_\_, Recorded Plat \_\_\_\_\_

5. Private Claims \_\_\_\_\_

~~SURVEY & RE-MONUMENTATION~~

APR 04 1996


COMMISSION

STATE OF MICHIGAN  
COUNTY OF MUSKEGON  
RECORDED  
1995 DEC 18 PM 4:14

Register of Deeds Stamp & File Number

I, Stephen V. Vallier, P.S., in a field survey on November 7, 1995, do hereby certify that under requirements of P.A. 74, Michigan P.A. of 1970, the corner points mentioned in lines 1 and 2 above were in conformance with regulations and rules therofore as required in the current manual of survey instructions of the United States Department of the Interior, Bureau of Land Management or by a decree of a Court of Law and/or that the corner points mentioned in lines 3, 4 and 5 above were in conformance with the rules of the Michigan Board of Land Surveyors or by a Decree of a Court of Law; established, re-established, monumented, re-monumented, recovered, found as expressed below:

NOTE: Not more than 4 corners, all in the same town and range, may be recorded on this certificate.

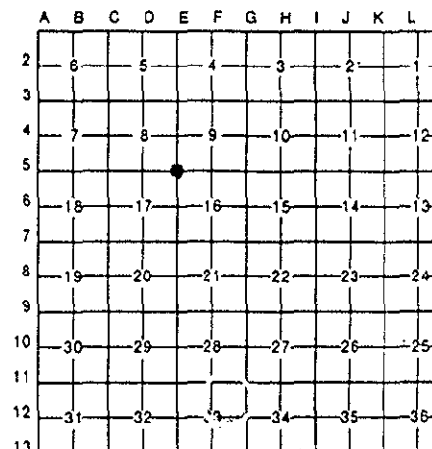

A. Description of original monument and accessories and/or subsequent restoration:

- 1837 GLO set corner 9" Maple for corner
- N 42 deg. E 19 Links 12" Maple
- 1987 J. Lazarock found 3/4" Iron Pipe. Reset 1/2" rod in Monument Box. Recorded LCRC Liber 1422 Page 177
- NE 91.58' Power Pole
- NW 46.93' Light Pole
- SW 51.48' Telephone Pole
- SE 59.20' Telephone Pole

(see Exhibit "A")

B. Description of corner evidence found and/or method applied in restoring or reestablishing corner:


Found 2 3/4" x 30" Cast Iron Monument with County Survey Cap in Monument Box. Check ties of LCRC Liber 1547 Page 681.

POSITION OF SAID  
RECORDED CORNER  
REVIEWED & RATIFIED  
BY MUSKEGON COUNTY  
PEER GROUP IN ACCORDANCE  
WITH P.A. 345, OF 1990

Nov. 13, 1995

C. Description of monument for corner and accessories established to perpetuate locating the position of the corner:  
Found 2 3/4" x 30" Cast Iron Monument with County survey Cap in Monument Box.

- N 38 deg. W 46.93' Telephone Pole (found nail)
- N 54 deg. E 91.58' Power Pole (found nail)
- S 47 deg. E 59.20' Telephone Pole (found nail)
- S 39 deg. W 51.61' Power Pole (set nail)

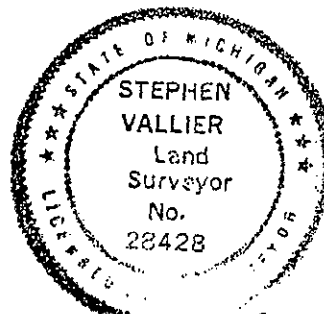

Signed by Stephen V. Vallier Date 12/15/95  
Surveyor's Michigan License No. 28428