

LAND CORNER RECORDATION CERTIFICATE  
Filing Requirement of Act 74, Mich. P.A. 1970

STATE OF MICHIGAN  
COUNTY OF MUSKEGON  
REGISTER OF DEEDS

For corners in Muskegon County Located in: Corner Code #

1. Public Land Survey T 11N R 17W E-6  
T \_\_\_\_\_ R \_\_\_\_\_  
T \_\_\_\_\_ R \_\_\_\_\_  
T \_\_\_\_\_ R \_\_\_\_\_

2. Property Controlling S \_\_\_\_\_ T \_\_\_\_\_ R \_\_\_\_\_  
in Section S \_\_\_\_\_ T \_\_\_\_\_ R \_\_\_\_\_

3. Miscellaneous S \_\_\_\_\_ T \_\_\_\_\_ R \_\_\_\_\_  
Property in Sec. S \_\_\_\_\_ T \_\_\_\_\_ R \_\_\_\_\_

4. Lot No \_\_\_\_\_, Recorded Plat \_\_\_\_\_  
5. Private Claims \_\_\_\_\_

AO1767

1996 DEC 23 AM 10:15

*Carroll*  
REGISTER OF DEEDS

Register of Deeds Stamp & File Number

I, Donald G. Sandel, in a field survey on Nov. 20, 1996 hereby certify that under requirements of P.A. 74, Michigan P.A. of 1970, the corner points mentioned in lines 1 and 2 above were in conformance with regulations and rules therefore as required in the current manual of survey instructions of the United States Department of the Interior, Bureau of Land Management or by a decree of a Court of Law and/or that the corner points mentioned in lines 3, 4 and 5 above were in conformance with the rules of the Michigan Board of Land Surveyors or by a Decree of a Court of Law; established, re-established, monumented, re-monumented, recovered, found as expressed below:

NOTE: Not more than 4 corners, all in the same town and range, may be recorded on this certificate.

	A	B	C	D	E	F	G	H	I	J	K	L	M
2	6	5	4	3	2	1							
3													
4	7	8	9	10	11	12							
5													
6	18	17	16	15	14	13							
7													
8	19	20	21	22	23	24							
9													
10	30	29	28	27	26	25							
11													
12	31	32	33	34	35	36							
13													

SURVEY &  
REMONUMENTATION

MAR 21 1997

COMMISSION

A. Description of original monument and accessories and/or subsequent restoration:

- (1) GLO: Set quarter section post, July 6, 1837.  
6" Beech S34 degrees W .05 chains  
6" Beech N14 degrees E .13 chains

- (2) Muskegon County Road Commission (1950) 1 1/4" iron pipe: 12" Twin Maple NW 39.0', 14" W. Cherry NE 45.7', 12" Twin Oak SW 41.45'

- (3) Found 1/2" iron in centerline Orshal Road - D. Sandel #25870:  
N60 degrees E 20" W. Cherry, 45.09'  
S40 degrees W 24" Twin Oak, 40.59'  
S70 degrees E 24" Oak, 50.15'  
N55 degrees W 17" Twin Maple, 38.99'

POSITION OF SAID  
RECORDED CORNER  
REVIEWED & RATIFIED  
BY MUSKEGON COUNTY  
PEER GROUP IN ACCORDANCE  
WITH P.A. 345, OF 1990

B. Description of corner evidence found and/or method applied in restoring or reestablishing corner:


- (1) Found 1/2" pipe over 2" X 24" pipe at centerline of Orshal Road, verified corner location using existing witnesses.

- (2) Historical usage, documentation, and evidence of corner location reviewed and ratified by the Muskegon County Peer Group, April 2, 1996.

C. Description of monument for corner and accessories established to perpetuate locating the position of the corner:

Set 3" X 30" Cast Iron "County Survey" monument in place of found 1/2" pipe; witnessed as follows:

- N22°W, set nail NE side, 16" Maple, 48.45'
- N30°E, set nail NW side, 12" Popple, 62.28'
- N58°E, found nail S side, 20" Wild Cherry, 45.12'
- S69°E, found nail N side, 24" Oak, 51.22'
- S44°W, found nail SE side, 20" Twin Oak, 40.59'
- N55°W, found nail NE side, 18" Twin Maple, 38.95'

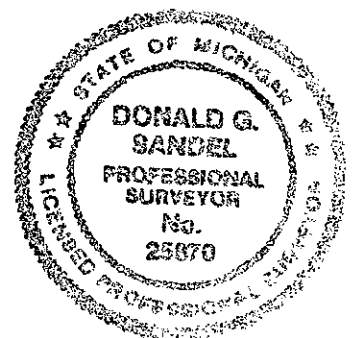

Signed by Donald G. Sandel  
Surveyor's Michigan License No. 25870

Date 19 December 1996