

81871 P. 630

A1742

LAND CORNER RECORDATION CERTIFICATE
Filing Requirement of Act 74, Mich. P.A. 1970

For corners in
Muskegon
(County)


Located In: Corner Code #

- 1. Public Land Survey T 11N R 17W E-9
- T _____ R _____
- T _____ R _____
- T _____ R _____
- 2. Property Controlling S _____ T _____ R _____ SURVEY & REMONUMENTATION
- in Section S _____ T _____ R _____
- 3. Miscellaneous S _____ T _____ R _____
- Property in Sec. S _____ T _____ R _____ APR 04 1996

STATE OF MICHIGAN
COUNTY OF MUSKEGON
RECORDS & CLERK
1995 DEC 18 PM 4:17

Register of Deeds Stamp & File Number

- 4. Lot No. _____, Recorded Plat _____ COMMISSION
- 5. Private Claims _____

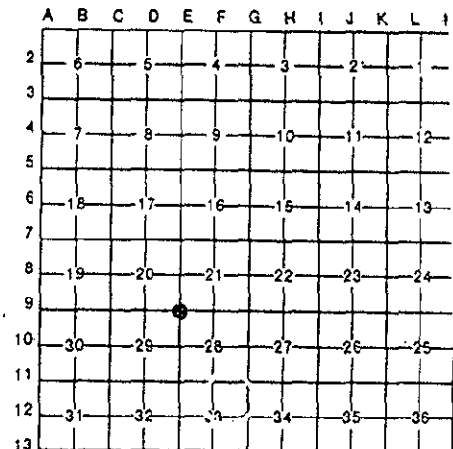

I, Stephen V. Vallier, P.S., in a field survey on February 22, 19 95, do hereby certify that under requirements of P.A. 74, Michigan P.A. of 1970, the corner points mentioned in lines 1 and 2 above were in conformance with regulations and rules therefore as required in the current manual of survey instructions of the United States Department of the Interior, Bureau of Land Management or by a decree of a Court of Law and/or that the corner points mentioned in lines 3, 4 and 5 above were in conformance with the rules of the Michigan Board of Land Surveyors or by a Decree of a Court of Law; established, re-established, monumented, re-monumented, recovered, found as expressed below:

NOTE: Not more than 4 corners, all in the same town and range, may be recorded on this certificate.

A. Description of original monument and accessories and/or subsequent restoration:

- 1837 GLO set corner S 14 deg. E 50 Links 10" White Oak
- N 44 deg. W 62 Links 11" Red Oak
- 1981 R. VanRiper found Railroad spike (Record LCRC Liber 1230 Page 367)
- NE 62.37' 26" Oak
- NW 54.36' 18" Oak
- SE 70.30' 8" Oak

(see Exhibit "A")

B. Description of corner evidence found and/or method applied in restoring or reestablishing corner:

Found 4" x 30" Cast Iron Monument with County Survey Cap. Checks witnesses from Section "A".

POSITION OF SAID
RECORDED CORNER
REVIEWED & RATIFIED
BY MUSKEGON COUNTY
PEER GROUP IN ACCORDANCE
WITH P.A. 345, OF 1990

Nov 13, 1995

C. Description of monument for corner and accessories established to perpetuate locating the position of the corner:
Found 4" x 30" Cast Iron Monument with County Survey Cap.

- N 30 deg. E 62.16' 26" Oak (nail)
- S 39 deg. E 70.36' 10" Oak (nail)
- N 55 deg. W 54.48' 20" Oak (nail)
- S 50 deg. W 36.99' Power Pole (nail N side)



Signed by Stephen Vallier Surveyor's Michigan License No. 28428

Date Dec 15, 1995