

A1809

MAR 21 1987

1996 DEC 23 PM 3:51

COMMISSION

LAND CORNER RECORDATION CERTIFICATE
Filing Requirement of Act 74, Mich. P.A. 1970

For corners in
Muskegon
(County)

Located In: Corner Code #

- 1. Public Land Survey T 11N R 17W F 10
T _____ R _____
T _____ R _____
T _____ R _____
- 2. Property Controlling in Section S _____ T _____ R _____
S _____ T _____ R _____
- 3. Miscellaneous Property in Sec. S _____ T _____ R _____
S _____ T _____ R _____

Carrie Carter
REGISTER OF DEEDS

Register of Deeds Stamp & File Number

- 4. Lot No. _____, Recorded Plat _____
- 5. Private Claims _____

	A	B	C	D	E	F	G	H	I	J	K	L	M
2	6		5		4		3		2		1		
3													
4	7		8		9		10		11		12		
5													
6	18		17		16		15		14		13		
7													
8	19		20		21		22		23		24		
9													
10	30		29		28		27		26		25		
11													
12	31		32		33		34		35		36		
13													

I, Ralph W VanRiper in a field survey on Dec. 12, 19 96

do hereby certify that under requirements of P.A. 74, Michigan P.A. of 1970, the corner points mentioned in lines 1 and 2 above were in conformance with regulations and rules therefore as required in the current manual of survey instructions of the United States Department of the Interior, Bureau of Land Management or by a decree of a Court of Law and/or that the corner points mentioned in lines 3, 4 and 5 above were in conformance with the rules of the Michigan Board of Land Surveyors or by a Decree of a Court of Law; established, re-established, monumented, re-monumented, recovered, found as expressed below:

NOTE: Not more than 4 corners, all in the same town and range, may be recorded on this certificate.

A. Description of original monument and accessories and/or subsequent restoration:


Center of Section 28, T 11 N, R 17 W, Fruitland Township
Not set by GLO Surveyors

MCRC 1950's Witness Sheets, Nothing shown at corner
MCRC Current Witness Book, 1 1/4" Pipe with 4 Witnesses
LCRC by Ralph W. VanRiper, RLS No. 16946, Set at intersection of 1/4 lines
L. 1230, P. 367

B. Description of corner evidence found and/or method applied in restoring or reestablishing corner:

Found 1 1/4" Pipe, with Cap marked RWVR, No. 16946

Verified location with existing witnesses

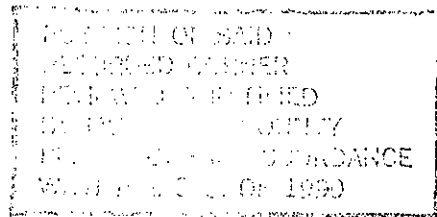

May 7, 1996

C. Description of monument for corner and accessories established to perpetuate locating the position of the corner:

Set 2 3/4" Cast Iron Monument with County Survey Cap

- N 41° E 33.00' Found Spike in W side of 12" Oak
- S 45° E 43.00' Set Spike in E side of 10" Oak
- S 87° E 16.40' Found Spike in N side of 12" Pine
- S 20° W 54.01' Set Spike in S side of 16" Oak
- S 55° W 13.40' Found Spike in S side of 8" Oak
- N 19° W 82.50' Found Spike in E side of 20" Oak



Signed by Ralph W. Van Riper
Surveyor's Michigan License No. 16946

Date 12/20/96

LIBEP 1951 PAGE 687

A1809