

**SURVEY & REMONUMENTATION**

MAR 21 1997

LIBER 1952 PAGE 806

STATE OF MICHIGAN  
COUNTY OF MUSKEGON  
REGISTER OF DEEDS RECORD

1996 DEC 30 AM 8:47

**LAND CORNER RECORDATION CERTIFICATE**  
Filing Requirement of Act 74, Mich. P.A. 1970

**COMMISSION**

For corners in  
MUSKEGON  
(County)

Located In: Corner Code #

- |                                    |                         |       |
|------------------------------------|-------------------------|-------|
| 1. Public Land Survey              | T 11N R 17W             | K-8.  |
|                                    | T _____ R _____         | _____ |
|                                    | T _____ R _____         | _____ |
|                                    | T _____ R _____         | _____ |
| 2. Property Controlling in Section | S _____ T _____ R _____ | _____ |
|                                    | S _____ T _____ R _____ | _____ |
| 3. Miscellaneous Property in Sec.  | S _____ T _____ R _____ | _____ |
|                                    | S _____ T _____ R _____ | _____ |

*Carrie Carter*  
REGISTER OF DEEDS

A1839

Register of Deeds Stamp & File Number

4. Lot No. \_\_\_\_\_, Recorded Plat \_\_\_\_\_  
5. Private Claims \_\_\_\_\_

STEPHEN V. VALLIER, in a field survey on OCTOBER 30 1996, do hereby certify that under requirements of P.A. 74, Michigan P.A. of 1970, the corner points mentioned in lines 1 and 2 above were in conformance with regulations and rules therefore as required in the current manual of survey instructions of the United States Department of the Interior, Bureau of Land Management or by a decree of a Court of Law and/or that the corner points mentioned in lines 3, 4 and 5 above were in conformance with the rules of the Michigan Board of Land Surveyors or by a Decree of a Court of Law; established, re-established, monumented, re-monumented, recovered, found as expressed below:

**NOTE: Not more than 4 corners, all in the same town and range, may be recorded on this certificate.**

| A  | B  | C  | D  | E  | F  | G  | H | I | J | K | L | M |
|----|----|----|----|----|----|----|---|---|---|---|---|---|
| 2  | 6  | 5  | 4  | 3  | 2  | 1  |   |   |   |   |   |   |
| 3  |    |    |    |    |    |    |   |   |   |   |   |   |
| 4  | 7  | 8  | 9  | 10 | 11 | 12 |   |   |   |   |   |   |
| 5  |    |    |    |    |    |    |   |   |   |   |   |   |
| 6  | 18 | 17 | 16 | 15 | 14 | 13 |   |   |   |   |   |   |
| 7  |    |    |    |    |    |    |   |   |   |   |   |   |
| 8  | 19 | 20 | 21 | 22 | 23 | 24 |   |   |   |   |   |   |
| 9  |    |    |    |    |    |    |   |   |   |   |   |   |
| 10 | 30 | 29 | 28 | 27 | 26 | 25 |   |   |   |   |   |   |
| 11 |    |    |    |    |    |    |   |   |   |   |   |   |
| 12 | 31 | 32 | 33 | 34 | 35 | 36 |   |   |   |   |   |   |
| 13 |    |    |    |    |    |    |   |   |   |   |   |   |

A. Description of original monument and accessories and/or subsequent restoration:

- |      |  |                |          |            |
|------|--|----------------|----------|------------|
| 1837 | G.L.O. SET CORNER                        | SOUTH 32° WEST | 4 LINKS  | 9" HEMLOCK |
|      |  | NORTH 25° EAST | 13 LINKS | 6" BEECH   |
| 1889 | MUSKEGON COUNTY SURVEYOR RECORDS PAGE 42 |                |          |            |
|      | DISTANCE TO SOUTH 39.71 CHAINS           |                |          |            |
|      |  | NORTH 35° WEST | 68.30'   | POWER POLE |


SEE ATTACHED EXHIBIT "K-8"

B. Description of corner evidence found and/or method applied in restoring or reestablishing corner:

- CHECKS WITH EXISTING WITNESSES  
FOUND 4" X 32" CAST IRON MONUMENT WITH COUNTY SURVEYOR LEGEND IN ASPHALT
- |                |        |            |
|----------------|--------|------------|
| NORTH 40° EAST | 73.60' | POWER POLE |
| SOUTH 45° EAST | 59.55' | 28" PINE   |
| NORTH 35° WEST | 68.30' | POWER POLE |

CHECKS WITH SINGLE PROPORTIONATE MEASURE WITHIN 2 INCH ±  
AGREES WITH HISTORICAL USAGE AND RECORDS

POSITION OF SAID RECORDED CORNER REVIEWED & RATIFIED BY MUSKEGON COUNTY PEER GROUP IN ACCORDANCE WITH P.A. 345 OF 1990

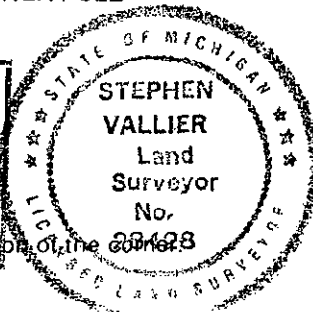

C. Description of monument for corner and accessories established to perpetuate locating the position of the corner:

- FOUND 4" X 32" CAST IRON MONUMENT WITH COUNTY SURVEYOR LEGEND IN ASPHALT
- |                |        |            |             |
|----------------|--------|------------|-------------|
| NORTH 40° EAST | 73.60' | POWER POLE | FOUND SPIKE |
| SOUTH 45° EAST | 59.55' | 28" PINE   | FOUND SPIKE |
| NORTH 35° WEST | 68.30' | POWER POLE | FOUND SPIKE |

Signed by *Stephen Vallier*  
Surveyor's Michigan License No. 28428

Date Dec 27, 1996

A1839

900

LIBER 1952 PAGE 806

EXHIBIT K-8

LIBER 1952 PAGE 807

1950's MUSKEGON COUNTY ROAD COMMISSION IRON ROD IN LEAD PIPE

|                 |        |                |
|-----------------|--------|----------------|
| NORTH/NORTHWEST | 81.55' | 36" ELM        |
| SOUTHWEST       | 46.59' | TELEPHONE POLE |
| SOUTHEAST       | 59.55' | 28" PINE       |
| SOUTH/SOUTHEAST | 86.30' | POWER POLE     |
| NORTH 40° EAST  | 78.60' | POWER POLE     |
| SOUTH 45° EAST  | 59.55' | 28" PINE       |

DISTANCE NORTH 2635.36'

DISTANCE SOUTH 2632.28'

LIBER 1297, PAGE 942 BY C.F. LEWANDOSKI

AUGUST 1984 3/4" PIPE INSIDE 1" PIPE

SET 4" X 32" CAST IRON MONUMENT WITH COUNTY SURVEYOR LEGEND