

SURVEY & REMONUMENTATION

LIBEP 1952 PAGE 808

MAR 21 1997

LAND CORNER RECORDATION CERTIFICATE

COMMISSION

Filing Requirement of Act 74, Mich. P.A. 1970

STATE OF MICHIGAN
COUNTY OF MUSKEGON
REGISTERED RECORD

1996 DEC 30 AM 8:48

For corners in
Muskegon
(County)

Located In:

Corner Code #

- | | | |
|------------------------------------|-------------------------|-------|
| 1. Public Land Survey | T 11N R 17W | K-11 |
| | T _____ R _____ | _____ |
| | T _____ R _____ | _____ |
| | T _____ R _____ | _____ |
| 2. Property Controlling in Section | S _____ T _____ R _____ | _____ |
| | S _____ T _____ R _____ | _____ |
| 3. Miscellaneous Property in Sec. | S _____ T _____ R _____ | _____ |
| | S _____ T _____ R _____ | _____ |

Carrie Carter
REGISTER OF DEEDS

A1840

Register of Deeds Stamp & File Number

4. Lot No. _____, Recorded Plat _____
5. Private Claims _____

I, S. Shackelford, P.S., in a field survey on October 30, 1996, do hereby certify that under requirements of P.A. 74, Michigan P.A. of 1970, the corner points mentioned in lines 1 and 2 above were in conformance with regulations and rules therefore as required in the current manual of survey instructions of the United States Department of the Interior, Bureau of Land Management or by a decree of a Court of Law and/or that the corner points mentioned in lines 3, 4 and 5 above were in conformance with the rules of the Michigan Board of Land Surveyors or by a Decree of a Court of Law; established, re-established, monumented, re-monumented, recovered, found as expressed below:

NOTE: Not more than 4 corners, all in the same town and range, may be recorded on this certificate.

A	B	C	D	E	F	G	H	I	J	K	L
2	6	5	4	3	2						
3											
4	7	8	9	10	11	12					
5											
6	18	17	16	15	14	13					
7											
8	19	20	21	22	23	24					
9											
10	30	29	28	27	26	25					
11											
12	31	32	33	34	35	36					
13											

A. Description of original monument and accessories and/or subsequent restoration:

- 1837 G.L.O
10" MAPLE AT CORNER
SOUTH 45° WEST 2 LINKS 16" MAPLE
1889 ABBOTT COUNTY SURVEY RECORDS PAGE 41
OLD WITNESS TREES TURNED OVER SET STAKE TOOK NEW WITNESSES
SET STAKE NEW WITNESSES SOUTH 63°30 MINUTES WEST 0.69 CHAINS 24" PINE STUMP

(SEE EXHIBIT K-11)


B. Description of corner evidence found and/or method applied in restoring or reestablishing corner:

- FOUND 4" X 32" CAST IRON MONUMENT WITH COUNTY SURVEYOR LEGEND IN ASPHALT
NORTH 40° EAST 50.20' TELEPHONE POLE SET SPIKE SOUTHEAST SIDE
NORTH 45° WEST 50.00' POWER POLE SET SPIKE SOUTHWEST SIDE
SOUTH 50° EAST 45.65' GUY POLE SET SPIKE SOUTHWEST SIDE
SOUTH 20° WEST 42.98' SOUTH END CURB AND GUTTER
PRORATED CHAINS NORTH AND SOUTH CHECK REASONABLY CLOSE TO 1889 MEASURES
CHECKS WITH HISTORICAL USAGE POSITION

POSITION OF SAID
RECORDED CORNER
REVIEWED & RATIFIED
BY MUSKEGON COUNTY
PEER GROUP IN ACCORDANCE
WITH P.A. 345, OF 1990
9/10/96

C. Description of monument for corner and accessories established to perpetuate locating the position of the corner:

- FOUND 4" X 32" CAST IRON MONUMENT WITH COUNTY SURVEYOR LEGEND IN ASPHALT
NORTH 40° EAST 50.20 TELEPHONE POLE SET SPIKE SOUTHEAST SIDE
NORTH 45° WEST 50.00 POWER POLE SET SPIKE SOUTHWEST SIDE
SOUTH 50° EAST 45.65 GUY POLE SET SPIKE SOUTHWEST SIDE
SOUTH 20° WEST 42.98 SOUTH END CURB AND GUTTER

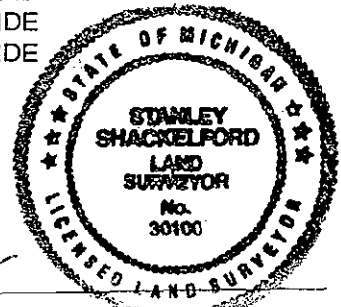

Signed by Stanley N. Shackelford 30100
Surveyor's Michigan License No. _____

Date 12-26-96

A1840

LIBEP 1952 PAGE 808

EXHIBIT K-11

1920	S SQUARE HEAD BOLT	NORTH 30° WEST	1.03 CHAINS	30" PINE STUMP
		NORTHEAST	33.50'	NAIL IN TELEPHONE POLE
		SOUTHWEST	43.40'	NAIL IN FENCE POST
DISTANCE		SOUTH	40.38'	CHAINS
DISTANCE		NORTH	40.07'	CHAINS
		SOUTHEAST	38.10'	NAIL IN FENCE POST
1950's	M.C.R.C TACK			
		SOUTHWEST	43.60'	FENCE POST
		NORTHEAST	44.50'	TELEPHONE POLE
		NORTHWEST	49.71'	FENCE POST
		WEST/NORTHWEST	106.4	TELEPHONE POLE
1983	LIBER 1258, PAGE 270 BY C.F.L			
	FOUND 1 1/4" PIPE IN MONUMENT BOX AT INTERSECTION OF BLACK TOP ROADS			
	CHECKS WITH EXISTING WITNESSES			
	SET 4" X 32" CAST IRON MONUMENT WITH COUNTY SURVEYOR LEGEND			
		SOUTH 85° WEST	175.10'	26" MAPLE
		NORTH 70° WEST	109.23'	GUY POLE
		NORTH 45° EAST	49.80'	TELEPHONE POLE
1984	LIBER 1288, PAGE 922 BY S. SHACKELFORD			
	FOUND 4" X 32" CAST IRON MONUMENT			
		NORTHEAST	49.90	TELEPHONE POLE
		WEST/NORTHWEST	109.23	GUY POLE
		SOUTH/SOUTHWEST	42.98	SOUTH END CURB AND GUTTER
		SOUTHWEST	43.60	FENCE POST