

**SURVEY & REMONUMENTATION**

LIBEP 1952 PAGE 810

MAR 21 1997

STATE OF MICHIGAN  
COUNTY OF MUSKEGON  
RECEIVED RECORDS  
1996 DEC 30 AM 8:48

**COMMISSION LAND CORNER RECORDATION CERTIFICATE**  
Filing Requirement of Act 74, Mich. P.A. 1970

For corners in  
Muskegon  
(County)

Located In:	Corner Code #
T 11N R 17W	K-12
T _____ R _____	_____
T _____ R _____	_____
T _____ R _____	_____
T _____ R _____	_____
S _____ T _____ R _____	_____
S _____ T _____ R _____	_____
S _____ T _____ R _____	_____
S _____ T _____ R _____	_____

*Carric Carter*  
REGISTER OF DEEDS

A1841

Register of Deeds Stamp & File Number

4. Lot No. \_\_\_\_\_, Recorded Plat \_\_\_\_\_  
5. Private Claims \_\_\_\_\_

I, Stanley H. Shackelford, P.S. in a field survey on OCTOBER 31, 19 96, do hereby certify that under requirements of P.A. 74, Michigan P.A. of 1970, the corner points mentioned in lines 1 and 2 above were in conformance with regulations and rules therefore as required in the current manual of survey instructions of the United States Department of the Interior, Bureau of Land Management or by a decree of a Court of Law and/or that the corner points mentioned in lines 3, 4 and 5 above were in conformance with the rules of the Michigan Board of Land Surveyors or by a Decree of a Court of Law; established, re-established, monumented, re-monumented, recovered, found as expressed below:

	A	B	C	D	E	F	G	H	I	J	K	L	M
2	6	5	4	3	2	1							
3													
4	7	8	9	10	11	12							
5													
6	18	17	16	15	14	13							
7													
8	19	20	21	22	23	24							
9													
10	30	29	28	27	26	25							
11													
12	31	32	33	34	35	36							
13													

**NOTE: Not more than 4 corners, all in the same town and range, may be recorded on this certificate.**

- A. Description of original monument and accessories and/or subsequent restoration:

1837 G.L.O. SET CORNER  
SOUTH 33° WEST 28 LINKS 10" ELM  
NORTH 31° WEST 5 LINKS 10" ELM  
1889 CORNER NOT DESCRIBED  
DISTANCE NORTH 40.38 CHAINS  
STRAIGHT LINE FOR MILE DISTANCE NORTH 40.84 CHAINS

POSITION OF SAID CORNER  
RECORDED CORNER 8/20/96  
REVIEWED & RATIFIED  
BY MUSKEGON COUNTY  
PEER GROUP IN ACCORDANCE  
WITH P.A. 345, OF 1990

SEE ATTACHED EXHIBIT "K-12"


- B. Description of corner evidence found and/or method applied in restoring or reestablishing corner:

FOUND 4" X 32" CAST IRON MONUMENT WITH COUNTY SURVEYOR LEGEND IN ASPHALT  
NORTH 65° WEST 45.71' 12" ALDER  
SOUTH 60° EAST 54.15' 12" MAPLE  
SOUTH 30° WEST 74.15' 12" OAK  
WEST 33.00' 1/2" REROD  
CHECKS WITH POSITION OF HISTORICAL USAGE AND SINGLE PROPORTIONATE MEASURE  
1889 RECORDS INDICATE CORNER POSSIBLY 30 FEET ± NORTH OF SINGLE PROPORTIONATE

LIBEP 1952 PAGE 810

- C. Description of monument for corner and accessories established to perpetuate locating the position of the corner:

FOUND 4" X 32" CAST IRON MONUMENT WITH COUNTY SURVEYOR LEGEND IN ASPHALT  
NORTH 65° WEST 45.71' 12" ALDER FOUND SPIKE  
SOUTH 60° EAST 54.15' 12" MAPLE FOUND SPIKE  
SOUTH 30° WEST 74.15' 24" OAK FOUND SPIKE  
WEST 33.00' 1/2" REROD FOUND

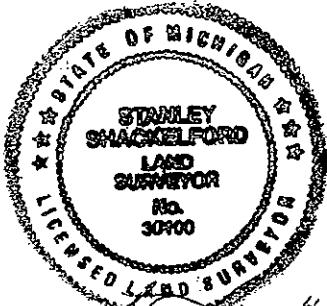

Signed by Stanley H. Shackelford Date 12-26-96  
Surveyor's Michigan License No. 30400

A1841

9/20

1950's MUSKEGON COUNTY ROAD COMMISSION NOT DESCRIBED

WEST	38.40'	10" ELM
SOUTHWEST	58.00'	20" ELM
SOUTHEAST	53.00'	20" ELM

1974 LIBER 1036, PAGE 232 BY F. SMITH  
FOUND 3/4-INCH PIPE

NORTHWEST	45.71'	8" ELDER
SOUTHWEST	74.08'	20" WILD CHERRY
EAST SOUTHEAST	54.15'	10" MAPLE

1983 LIBER 1258 PAGE 271 BY C.F.L.  
FOUND 1 1/4-INCH PIPE ON TOP OF 1-INCH SOLID IRON  
SET 4" X 32" CAST IRON MONUMENT WITH COUNTY SURVEYOR LEGEND

NORTH 65° WEST	45.71'	12" ALDER
WEST	33.00'	1/2-" ROD
SOUTH 30° WEST	74.15'	24" OAK
SOUTH 60° EAST	54.15'	12" MAPLE