

1994 DEC 29 AM 10:15

LAND CORNER RECORDATION CERTIFICATE
Filing Requirement of Act 74, Mich. P.A. 1970

For corners in

Muskegon
(County)

Located In:

Corner Code #

Carrie Carter
REGISTER OF DEEDS

- | | | |
|------------------------------------|-------------------------|-------------------------|
| 1. Public Land Survey | T <u>11</u> R <u>17</u> | SURVEY & |
| | T _____ R _____ | REMONUMENTATION |
| | T _____ R _____ | |
| | T _____ R _____ | |
| 2. Property Controlling in Section | S _____ T _____ R _____ | APR 28 1995 |
| | S _____ T _____ R _____ | |
| 3. Miscellaneous Property in Sec. | S _____ T _____ R _____ | COMMISSION |
| | S _____ T _____ R _____ | |

A1616

Register of Deeds Stamp & File Number

4. Lot No. _____, Recorded Plat _____
5. Private Claims _____

I, Stephen V. Vallier a field survey on December, 1994, do hereby certify that under requirements of P.A. 74, Michigan P.A. of 1970, the corner points mentioned in lines 1 and 2 above were in conformance with regulations and rules therefore as required in the current manual of survey instructions of the United States Department of the Interior, Bureau of Land Management or by a decree of a Court of Law and/or that the corner points mentioned in lines 3, 4 and 5 above were in conformance with the rules of the Michigan Board of Land Surveyors or by a Decree of a Court of Law; established, re-established, monumented, re-monumented, recovered, found as expressed below:

	A	B	C	D	E	F	G	H	I	J	K	L	M
2	6		5		4		3		2		1		
3													
4	7		8		9		10		11		12		
5													
6	18		17		16		15		14		13		
7													
8	19		20		21		22		23		24		
9													
10	30		29		28		27		26		25		
11													
12	31		32		33		34		35		36		
13													


NOTE: Not more than 4 corners, all in the same town and range, may be recorded on this certificate.

A. Description of original monument and accessories and/or subsequent restoration:

- 1837 GLO set corner
- 1950's M.C.R.C. Tie Map - old spring
- 1976 M.C.R.C. - L.C.R.C. Liber 1116 Page 865 - 1/2" iron in monument box
- 1984 C.F. Lewandowski - L.C.R.C. Liber 1283 page 379 - Found 1/2" iron rod in monument box. Reset with 2 3/4" x 30" cast iron monument with County Survey cap.

B. Description of corner evidence found and/or method applied in restoring or reestablishing corner:

Found 2 3/4" cast iron monument with County Survey Cap in monument box. Accepted position of corner due to evidence of Historical usage and Consistent documentation.

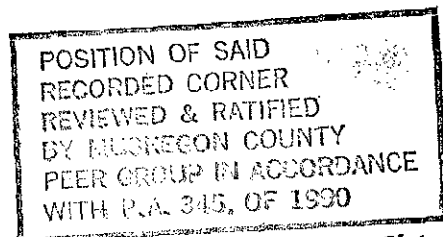


Aug 3, 1993

C. Description of monument for corner and accessories established to perpetuate locating the position of the corner:

2 3/4" cast iron monument with County survey cap in monument box.

- N 45 deg W 50.35' Telephone Pole with nail
- N 60 deg E 76.07' Telephone Pole with nail
- S 63 deg E 71.74' 16" Oak with nail
- S 32 deg W 43.64' 10" Oak with nail
- N 65 deg W 58.95' U.S.G.S.

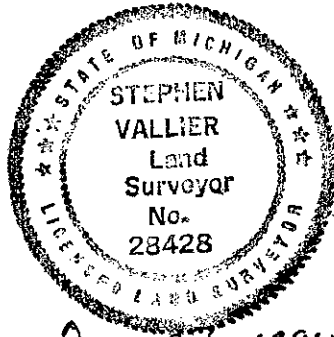

Signed by *Stephen Vallier*

Date *Dec 27, 1994*

Surveyor's Michigan License No. 28428