

*Carrie Carter*  
REGISTER OF DEEDS

LIBER 1810 PAGE 590

LAND CORNER RECORDATION CERTIFICATE  
Filing Requirement of Act 74, Mich. P.A. 1970

For corners in

Muskegon  
(County)

Located In:

Corner Code #

1. Public Land Survey

T 11 R 17

SURVEY &  
REMONUMENTATION

*A1614*

2. Property Controlling  
in Section

S \_\_\_ T \_\_\_ R \_\_\_  
S \_\_\_ T \_\_\_ R \_\_\_

APR 28 1995

3. Miscellaneous  
Property in Sec.

S \_\_\_ T \_\_\_ R \_\_\_  
S \_\_\_ T \_\_\_ R \_\_\_

COMMISSION

Register of Deeds Stamp & File Number

4. Lot No. \_\_\_\_\_, Recorded Plat \_\_\_\_\_

5. Private Claims \_\_\_\_\_

	A	B	C	D	E	F	G	H	I	J	K	L	M
2	6	5		4		3		2		1			
3													
4	7	8	9	10	11	12							
5													
6	18	17	16	15	14	13							
7													
8	19	20	21	22	23	24							
9													
10	30	29	28	27	26	25							
11													
12	31	32	33	34	35	36							
13													

I, Stephen V. Vallier, in a field survey on December, 19 94,

do hereby certify that under requirements of P.A. 74, Michigan P.A. of 1970, the corner points mentioned in lines 1 and 2 above were in conformance with regulations and rules therefore as required in the current manual of survey instructions of the United States Department of the Interior, Bureau of Land Management or by a decree of a Court of Law and/or that the corner points mentioned in lines 3, 4 and 5 above were in conformance with the rules of the Michigan Board of Land Surveyors or by a Decree of a Court of Law; established, re-established, monumented, re-monumented, recovered, found as expressed below:


**NOTE: Not more than 4 corners, all in the same town and range, may be recorded on this certificate.**

A. Description of original monument and accessories and/or subsequent restoration:

- 1837 GLO set corner
- 1950's M.C.R.C. Tie Map
- 1984 C.F. Lewandowski - L.C.R.C. Liber 1297 Page 943 - Found 1" iron pipe in monument box - Reset 2 3/4" cast iron monument with County Survey Cap in monument box.

B. Description of corner evidence found and/or method applied in restoring or reestablishing corner:


Found 2 3/4" cast iron monument in monument box with County Survey Cap. Accepted position of corner due to evidence of Historical usage and consistent documentation.

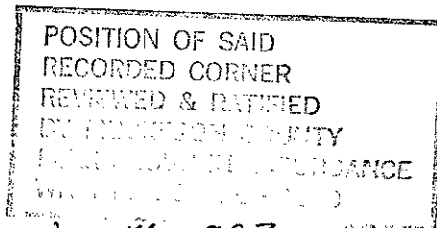

C. Description of monument for corner and accessories established to perpetuate locating the position of the corner:

2 3/4" Cast Iron monument with County Survey Cap in Monument Box.

- S 75 deg. W 56.14' Telephone Pole with nail
- S 75 deg. E 49.22' Telephone Pole with nail
- N 35.98' 35" Walnut with nail
- S 15 deg. W 88.05' Telephone Pole with nail

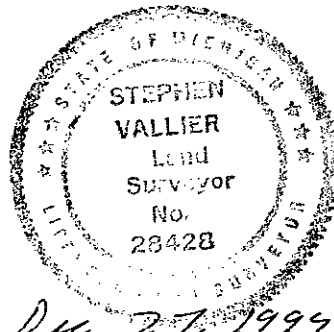

Signed by *Stephen Vallier*

Date Dec 27, 1994

Surveyor's Michigan License No. 28428