

LAND CORNER RECORDATION CERTIFICATE
Filing Requirement of Act 74, Mich. P.A. 1970

1994 DEC 29 AM 10:15

For corners in

Muskegon
(County)

Located In:

Corner Code #

- 1. Public Land Survey T 11 R 17 L-8
T _____ R _____ SURVEY &
T _____ R _____ REMONUMENTATION
T _____ R _____
- 2. Property Controlling S _____ T _____ R _____
in Section S _____ T _____ R _____ APR 28 1995
- 3. Miscellaneous S _____ T _____ R _____
Property in Sec. S _____ T _____ R _____ COMMISSION

Carrie Carter
REGISTER OF DEEDS

A1613

Register of Deeds Stamp & File Number

- 4. Lot No. _____, Recorded Plat _____
- 5. Private Claims _____

	A	B	C	D	E	F	G	H	I	J	K	L	M
2	6	5	4	3	2	1							
3													
4	7	8	9	10	11	12							
5													
6	18	17	16	15	14	13							
7													
8	19	20	21	22	23	24							
9													
10	30	29	28	27	26	25							
11													
12	31	32	33	34	35	36							
13													

I, Stephen V. Vallier, in a field survey on December, 19 94, do hereby certify that under requirements of P.A. 74, Michigan P.A. of 1970, the corner points mentioned in lines 1 and 2 above were in conformance with regulations and rules therefore as required in the current manual of survey instructions of the United States Department of the Interior, Bureau of Land Management or by a decree of a Court of Law and/or that the corner points mentioned in lines 3, 4 and 5 above were in conformance with the rules of the Michigan Board of Land Surveyors or by a Decree of a Court of Law; established, re-established, monumented, re-monumented, recovered, found as expressed below:


NOTE: Not more than 4 corners, all in the same town and range, may be recorded on this certificate.

A. Description of original monument and accessories and/or subsequent restoration:

GL0 Corner not set
1950's M.C.R.C. Tie Map - 3/4" Iron Pipe
1984 L.F. Lewandowski - L.C.R.C. Liber 1297 Page 941 - Found 1/2" Iron Pipe in monument box - Reset with 2 3/4" x 30" Cast Iron Monument with County Survey Cap.

B. Description of corner evidence found and/or method applied in restoring or reestablishing corner:

Found 2 3/4" cast iron monument with County survey Cap in Monument Box. Accepted position of corner due to evidence of Historical usage and consistent documentation.

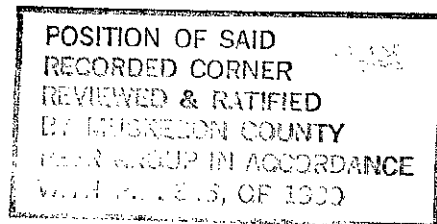


Dec 14, 1993 SV

C. Description of monument for corner and accessories established to perpetuate locating the position of the corner:

2 3/4" Cast Iron Monument with County Survey Cap in Monument Box.

- N 20 deg W 59.90' Telephone Pole with nail
- N 50 deg E 82.50' Power Pole with nail
- S 30.10' 24" Maple with nail
- S 50 deg W 47.30' 24" Maple with nail

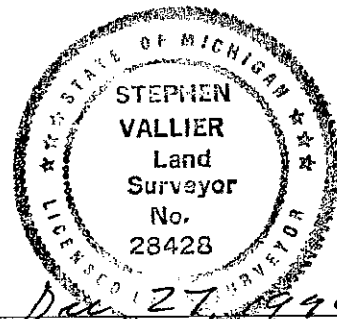

Signed by *Stephen Vallier*

Date Dec 27, 1994

Surveyor's Michigan License No. 28428