

LAND CORNER RECORDATION CERTIFICATE  
Filing Requirement of Act 74, Mich. P.A. 1970

1994 DEC 29 AM 10:15

For corners in

Muskegon  
(County)

Located In:

Corner Code #

*Carrie Carter*  
REGISTER OF DEEDS

- 1. Public Land Survey T 11 R 17 M-1  
T \_\_\_\_\_ R \_\_\_\_\_ SURVEY &  
T \_\_\_\_\_ R \_\_\_\_\_ REMONUMENTATION  
T \_\_\_\_\_ R \_\_\_\_\_
- 2. Property Controlling S \_\_\_\_\_ T \_\_\_\_\_ R \_\_\_\_\_  
in Section S \_\_\_\_\_ T \_\_\_\_\_ R \_\_\_\_\_ APR 28 1995
- 3. Miscellaneous S \_\_\_\_\_ T \_\_\_\_\_ R \_\_\_\_\_  
Property in Sec. S \_\_\_\_\_ T \_\_\_\_\_ R \_\_\_\_\_ COMMISSION

*A1615*

Register of Deeds Stamp & File Number

- 4. Lot No. \_\_\_\_\_, Recorded Plat \_\_\_\_\_
- 5. Private Claims \_\_\_\_\_

	A	B	C	D	E	F	G	H	I	J	K	L	M
2	6		5		4		3		2		1		
3													
4	7		8		9		10		11		12		
5													
6	18		17		16		15		14		13		
7													
8	19		20		21		22		23		24		
9													
10	30		29		28		27		26		25		
11													
12	31		32		33		34		35		36		
13													

I, Stephen V. Vallier of a field survey on December, 1994 do hereby certify that under requirements of P.A. 74, Michigan P.A. of 1970, the corner points mentioned in lines 1 and 2 above were in conformance with regulations and rules therefore as required in the current manual of survey instructions of the United States Department of the Interior, Bureau of Land Management or by a decree of a Court of Law and/or that the corner points mentioned in lines 3, 4 and 5 above were in conformance with the rules of the Michigan Board of Land Surveyors or by a Decree of a Court of Law; established, re-established, monumented, re-monumented, recovered, found as expressed below:

NOTE: Not more than 4 corners, all in the same town and range, may be recorded on this certificate.

A. Description of original monument and accessories and/or subsequent restoration:

- 1837 GLO set corner
- 1950's M.C.R.C. Tie Map - witnesses only
- 1984 C.F. Lewandowski - L.C.R.C. Liber 1299 Page 225 - Found 1 1/4" iron pipe in monument box. Reset 2 3/4" cast iron monument x 30" in monument box.

B. Description of corner evidence found and/or method applied in restoring or reestablishing corner:


Found 2 3/4" cast iron monument with County Survey cap in monument box. Accepted position of corner due to evidence of Historical usage and consistent documentation.

POSITION OF SAID  
RECORDED CORNER  
REVIEWED & RATIFIED  
BY MUSKEGON COUNTY  
PEER GROUP IN ACCORDANCE  
WITH P.A. 343, OF 1990  
*Dec 14, 1993*

C. Description of monument for corner and accessories established to perpetuate locating the position of the corner:

2 3/4" cast iron monument with County Survey Cap in monument box.

- S 50 deg. E 83.64' 16" Oak with nail
- S 10 deg W 77.63' 22" Oak with nail
- S 31 deg W 68.32' 8" Birch with nail

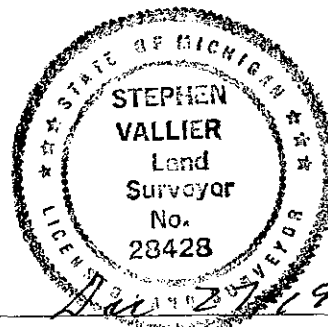

Signed by *Stephen Vallier*

Date *Dec 29, 1994*

Surveyor's Michigan License No. 28428