

1994 DEC 29 AM 10:15

LAND CORNER RECORDATION CERTIFICATE
Filing Requirement of Act 74, Mich. P.A. 1970

Carrie Carter
REGISTER OF DEEDS

For corners in

Muskegon
(County)

Located In:

Corner Code #

1. Public Land Survey

T 11 R 17
T _____ R _____
T _____ R _____
T _____ R _____

M-9
SURVEY &

REMONUMENTATION

A 1620

2. Property Controlling
in Section

S _____ T _____ R _____
S _____ T _____ R _____

APR 28 1995

3. Miscellaneous
Property in Sec.

S _____ T _____ R _____
S _____ T _____ R _____

COMMISSION

Register of Deeds Stamp & File Number

4. Lot No. _____, Recorded Plat _____

5. Private Claims _____

	A	B	C	D	E	F	G	H	I	J	K	L	M
2	6		5		4		3		2		1		
3													
4	7		8		9		10		11		12		
5													
6	18		17		16		15		14		13		
7													
8	19		20		21		22		23		24		
9													
10	30		29		28		27		26		25		
11													
12	31		32		33		34		35		36		
13													

Stephen V. Vallier a field survey on December, 19 94, do hereby certify that under requirements of P.A. 74, Michigan P.A. of 1970, the corner points mentioned in lines 1 and 2 above were in conformance with regulations and rules therefore as required in the current manual of survey instructions of the United States Department of the Interior, Bureau of Land Management or by a decree of a Court of Law and/or that the corner points mentioned in lines 3, 4 and 5 above were in conformance with the rules of the Michigan Board of Land Surveyors or by a Decree of a Court of Law; established, re-established, monumented, re-monumented, recovered, found as expressed below:

NOTE: Not more than 4 corners, all in the same town and range, may be recorded on this certificate.

A. Description of original monument and accessories and/or subsequent restoration:

- 1837 GLO set corner
- 1950's M.C.R.C. Tie Map - witnesses only
- 1983 C.F. Lewandowski - L.C.R.C. Liber 1260 Page 165 - Found 1/2" iron rod
Reset with 2 3/4" x 30" cast iron monument with County Survey Cap.

B. Description of corner evidence found and/or method applied in restoring or reestablishing corner:

Found 2 3/4" cast iron monument with County Survey Cap.
Accepted position of corner due to evidence of Historical usage and consistent documentation.


POSITION OF SAID
RECORDED CORNER
REVIEWED & RATIFIED
BY MUSKEGON COUNTY
PEER GROUP IN ACCORDANCE
WITH P.A. 345, OF 1990

Jan 14, 1997

C. Description of monument for corner and accessories established to perpetuate locating the position of the corner:

2 3/4" cast iron monument with County Survey Cap.

- S 50 deg E 55.00' 16" Maple with nail
- N 45 deg E 44.80' 14" Maple with nail
- N 55 deg W 80.75' 14" maple with nail

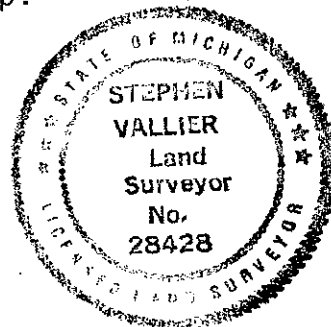

Signed by

Stephen Vallier

Date

Jan 27, 1994

Surveyor's Michigan License No.

28428