

**SURVEY & REMONUMENTATION**

LIBER 1952 PAGE 826

STATE OF MICHIGAN  
COUNTY OF MUSKEGON

MAR 21 1997

**LAND CORNER RECORDATION CERTIFICATE**  
Filing Requirement of Act 74, Mich. P.A. 1970

1952 MAR 30 11 0:48

For corners in MUSKEGON

**COMMISSION**

*Carroll*  
REGISTER OF DEEDS

A1849

Located In: \_\_\_\_\_ Corner Code # \_\_\_\_\_

1. Public Land Survey	T 11N R 17W	K-1	<i>Seq. #2</i>
	T _____ R _____	_____	_____
	T _____ R _____	_____	_____
	T _____ R _____	_____	_____
2. Property Controlling in Section	S _____ T _____ R _____	_____	_____
	S _____ T _____ R _____	_____	_____
3. Miscellaneous Property in Sec.	S _____ T _____ R _____	_____	_____
	S _____ T _____ R _____	_____	_____

Register of Deeds Stamp & File Number

- 4. Lot No. \_\_\_\_\_, Recorded Plat \_\_\_\_\_
- 5. Private Claims \_\_\_\_\_

A	B	C	D	E	F	G	H	I	J	K	L	M
2	6	5	4	3	2	1						
3												
4	7	8	9	10	11	12						
5												
6	18	17	16	15	14	13						
7												
8	19	20	21	22	23	24						
9												
10	30	29	28	27	26	25						
11												
12	31	32	33	34	35	36						
13												

I, Stephen V. Vallier, P.S., in a field survey on OCTOBER 30, 1996, do hereby certify that under requirements of P.A. 74, Michigan P.A. of 1970, the corner points mentioned in lines 1 and 2 above were in conformance with regulations and rules therefore as required in the current manual of survey instructions of the United States Department of the Interior, Bureau of Land Management or by a decree of a Court of Law and/or that the corner points mentioned in lines 3, 4 and 5 above were in conformance with the rules of the Michigan Board of Land Surveyors or by a Decree of a Court of Law; established, re-established, monumented, re-monumented, recovered, found as expressed below:

**NOTE: Not more than 4 corners, all in the same town and range, may be recorded on this certificate.**

**A. Description of original monument and accessories and/or subsequent restoration:**


- |        |  |                 |             |                    |
|--------|--|-----------------|-------------|--------------------|
| 1837   | G.L.O. SET CORNER  | SOUTH 27° WEST  | 30 LINKS    | 24" PINE TREE      |
|        |  | SOUTH 20½° EAST | 1.16 CHAINS | 10" WHITE OAK TREE |
| 1950's | MUSKEGON COUNTY ROAD COMMISSION - NO DESCRIPTION OF MONUMENT | SOUTHEAST       | 60.1'       | 8" PINE TREE       |
|        |  | SOUTHWEST       | 56.7'       | 18" MAPLE TREE     |
|        |  | SOUTHWEST       | 43.6'       | 8" MAPLE TREE      |
- SEE ATTACHED EXHIBIT K-1

**B. Description of corner evidence found and/or method applied in restoring or reestablishing corner:**

FOUND 4" X 30" CAST IRON MONUMENT WITH COUNTY SURVEYOR CAP IN MONUMENT BOX  
WITNESS CHECKED WITH L.C.R.C. LIBER 1240, PAGE 545  
ACCEPTED POSITION OF CORNER DUE TO HISTORICAL USAGE AND DOCUMENTATION OF RECORD

POSITION OF SAID *sw*  
RECORDED CORNER *8713/90*  
REVIEWED & RATIFIED  
BY MUSKEGON COUNTY  
PEER GROUP IN ACCORDANCE  
WITH P.A. 345, OF 1990

**SURVEY & REMONUMENTATION**  
**MAR 06 1998**  
**SECTION**

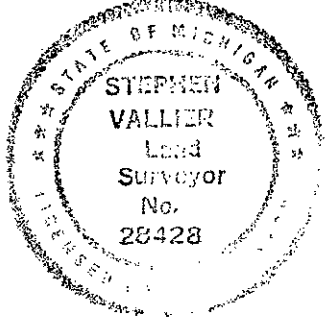

LIBER 1952 PAGE 826

**C. Description of monument for corner and accessories established to perpetuate locating the position of the corner:**

- FOUND 4" X 30" CAST IRON MONUMENT WITH COUNTY SURVEYOR CAP IN MONUMENT BOX
- |                                 |        |            |             |
|---------------------------------|--------|------------|-------------|
| NORTH 35° WEST                  | 37.90' | POWER POLE | FOUND SPIKE |
| SOUTH 40° EAST                  | 60.20' | 16" APPLE  | FOUND SPIKE |
| SOUTH 35° WEST                  | 57.10' | 14" MAPLE  | FOUND SPIKE |
| SOUTH 4005.34 TO K-2 (¼ CORNER) |        |            |             |

Signed by *Stephen Vallier* Date *Dec 27 1996*  
Surveyor's Michigan License No. 28428

A1849