

SURVEY & REMONUMENTATION

MAR 06 1998

LIBEP 2052 PAGE 594

LAND CORNER RECORDATION CERTIFICATE
Filing Requirement of Act 74, Mich. P.A. 1970

STATE OF MICHIGAN
 COUNTY OF MUSKEGON
 RECEIVED
 1997 DEC 30 PM 3:21
Carrie Carter
 REGISTER OF DEEDS

SECTION

For corners in

Muskegon	Located In:	Corner Code #
(County)		
1. Public Land Survey	T <u>12N</u> R <u>16W</u>	<u>C-4</u>
	T _____ R _____	_____
	T _____ R _____	_____
	T _____ R _____	_____
2. Property Controlling in Section	S _____ T _____ R _____	_____
	S _____ T _____ R _____	_____
3. Miscellaneous Property in Sec.	S _____ T _____ R _____	_____
	S _____ T _____ R _____	_____

Register of Deeds Stamp & File Number

4. Lot No. _____, Recorded Plat _____
 5. Private Claims _____

I, Stephen V. Vallier, P.S., in a field survey on November 25, 1997, do hereby certify that under requirements of P.A. 74, Michigan P.A. of 1970, the corner points mentioned in lines 1 and 2 above were in conformance with regulations and rules therefore as required in the current manual of survey instructions of the United States Department of the Interior, Bureau of Land Management or by a decree of a Court of Law and/or that the corner points mentioned in lines 3, 4 and 5 above were in conformance with the rules of the Michigan Board of Land Surveyors or by a Decree of a Court of Law; established, re-established, monumented, re-monumented, recovered, found as expressed below:

NOTE: Not more than 4 corners, all in the same town and range, may be recorded on this certificate.

A. Description of original monument and accessories and/or subsequent restoration:

- 1837 G.L.O. Set Post - J. Mullett
 South 48° East 4 Links 8 Inch White Oak
 South 16° West 20 Links 8 Inch White Oak
 1915 Concrete Monument Set By T. Norlin Survey, Section 8.
 Assumed G.L.O. Corner Was Found and Perpetuated.

A	B	C	D	E	F	G	H	I	J	K	L	M
2	6	5	4	3	2	1						
3												
4	7	8	9	10	11	12						
5												
6	18	17	16	15	14	13						
7												
8	19	20	21	22	23	24						
9												
10	30	29	28	27	26	25						
11												
12	31	32	33	34	35	36						
13												

POSITION OF SAID RECORDED CORNER REVIEWED & REIFIED BY MUSKEGON COUNTY PEER GROUP IN ACCORDANCE WITH P.A. 345, OF 1990


B. Description of corner evidence found and/or method applied in restoring or reestablishing corner:

SW 8/19/97

Concrete Monument Set By T. Norlin of 1915 Survey Obliterated.
 Area is now a gravel pit.
 Corner Set By Proportionate Measure (Present 1915) From Respective Section Corners and Center of section.
 Resulting Position Produces An Angle At the West Quarter Corner Within 01 Second of Norlin Angle.
 The Angle At the Center of Section is Also Within 06 Seconds From The West Quarter to the North Quarter.
 Total Mile of West Line is Within 3.5 Feet of 1915 Measure.
 Set 2 3/4 Inch By 30 Inch Cast Iron Monument With County Surveyor Cap - Witnessed

C. Description of monument for corner and accessories established to perpetuate locating the position of the corner:

2 3/4 Inch By 30 Inch Cast Iron Monument With County Surveyor Cap on North/South ancient Fence Line.	01.00 Feet	4 Inch Cedar Post	North Of Corner.
North 35° West	87.40 Feet	8 Inch Oak	Found Nail
North 50° East	27.84 Feet	8 Inch Wild Cherry	Found Nail South Side
South 66° West	48.49 Feet	18 Inch Oak	Found Nail Southeast Side
South 12° West	64.41 Feet	16 Inch Oak	Found Nail East Side
South 88° West	61.67 Feet	14 Inch White Oak	Found Nail North Side
South 39° West	24.10 Feet	10 Inch White Oak	Found Nail North Side
South 55° West	34.73 Feet	Telephone Pole	Found Nail South Side
South 82° West	78.93 Feet	20 Inch Pine	Found Nail North Side

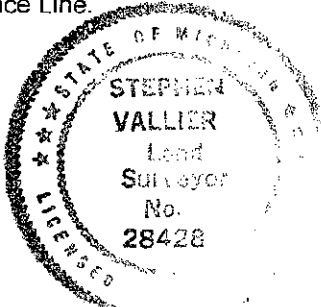

Signed by *Stephen V. Vallier* Date December 19, 1997
 Surveyor's Michigan License No. 28428

A1913