

JAN 31 2001

LIBER 3121 PAGE 660

LAND CORNER RECORDATION CERTIFICATE
Filing Requirement of Act 74, Mich. P.A. 1970

STATE OF MICHIGAN
COUNTY OF MUSKEGON
RECEIVED FOR RECORD

2000 DEC 20 PM 1:50

SECTION

For corners in
Muskegon County

Located in: Corner Code #

- 1. Public Land Survey T 12N R 17W A-2 ✓
T _____ R _____
T _____ R _____
T 12N R 18W M-2
- 2. Property Controlling S _____ T _____ R _____
in Section S _____ T _____ R _____
- 3. Miscellaneous S _____ T _____ R _____
Property in Sec. S _____ T _____ R _____
- 4. Lot No _____, Recorded Plat _____
- 5. Private Claims _____

Mark F. Fairchild
REGISTER OF DEEDS

Register of Deeds Stamp & File Number

I, Donald G. Sandel, in a field survey on August 2, 2000 hereby certify that under requirements of P.A. 74, Michigan P.A. of 1970, the corner points mentioned in lines 1 and 2 above were in conformance with regulations and rules therefore as required in the current manual of survey instructions of the United States Department of the Interior, Bureau of Land Management or by a decree of a Court of Law and/or that the corner points mentioned in lines 3, 4 and 5 above were in conformance with the rules of the Michigan Board of Land Surveyors or by a Decree of a Court of Law; established, re-established, monumented, re-monumented, recovered, found as expressed below:

	A	B	C	D	E	F	G	H	I	J	K	L	M
2	8		5		4		3		2		1		
3													
4	7		8		9		10		11		12		
5													
6	18		17		16		15		14		13		
7													
8	19		20		21		22		23		24		
9													
10	30		29		28		27		26		25		
11													
12	31		32		33		34		35		36		
13													

NOTE: Not more than 4 corners, all in the same town and range, may be recorded on this certificate.

POSITION OF SAID *Rectified*
RECORDED CORNER *sv*
REVIEWED & RATIFIED *8/1/00*
BY MUSKEGON COUNTY
PEER GROUP IN ACCORDANCE
WITH P.A. 345, OF 1990

A. Description of original monument and accessories and/or subsequent restoration:

- 1) GLO: Set quarter section post, October 9, 1837: Sugar Maple 15° S 28°W, 62 Chains, Sugar Maple 8° N 54°W, 37 chains.
- 2) Muskegon County Road Commission: NW 90.22' 24" Maple, WSW 91.17' 18" Cherry, SW 74.04' 15" Maple.
- 3) D. G. Sandel #25870 on 5-1-81 found 5/8" rod in center line of road: N61°W found Nail N side 40" Maple 90.25'; S80°W found nail N side 19" Cherry 91.07'; N83°E set nail N side 10" Red Pine 72.00'.


B. Description of corner evidence found and/or method applied in restoring or reestablishing corner:

- 1) Found 5/8" rod over 1" pipe at center line of Lamos Road. (N/S Asphalt). Used existing witnesses to verify corner location.
- 2) Historical usage, documentation, and evidence of corner location reviewed and ratified by the Muskegon County Peer Group, August 1, 2000.

C. Description of monument for corner and accessories established to perpetuate locating the position of the corner:

Set 2 3/4" x 31" cast Iron "County Survey" Monument stamped #25870 in place of found 5/8" rod; witnessed as follows:

- N35°E found nail w/RLS Tag SE side utility pole 120.10'
- N90°E set center of post "Pass w/care" sign 20.16'
- S29°E set center -top GTE Riser 54.45'
- S32°W set nail NW side 6" Pine 90.79'
- N57°W set nail NE side 10" Maple 51.26'
- N30°W set nail NE side 20" Maple 68.10'

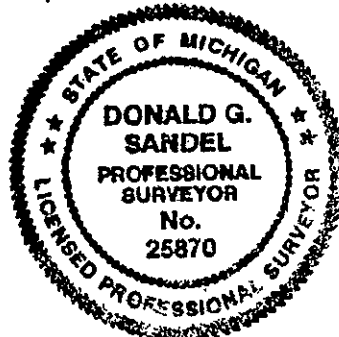

Signed by Donald G. Sandel
Surveyor's Michigan License No. 25870

Date 15 December 2000

A2128