

FEB 09 2000

LIBER 2324 PAGE 852

LAND CORNER RECORDATION CERTIFICATE  
Filing Requirement of Act 74, Mich. P.A. 1970

SECTION

For corners in Muskegon County Located in: Corner Code #

|                                      |                           |       |
|--------------------------------------|---------------------------|-------|
| 1. Public Land Survey                | T <u>12N</u> R <u>17W</u> | D-5   |
|                                      | T _____ R _____           | _____ |
|                                      | T _____ R _____           | _____ |
|                                      | T _____ R _____           | _____ |
| 2. Property Controlling in Section   | S _____ T _____ R _____   | _____ |
|                                      | S _____ T _____ R _____   | _____ |
| 3. Miscellaneous Property in Sec.    | S _____ T _____ R _____   | _____ |
|                                      | S _____ T _____ R _____   | _____ |
| 4. Lot No _____, Recorded Plat _____ |                           |       |
| 5. Private Claims _____              |                           |       |

1999 DEC 16 AM 11:00  
*Mark F. Fairchild*  
 Muskegon County  
 Register of Deeds  
 Muskegon, Michigan

Register of Deeds Stamp & File Number

|    | A  | B | C  | D | E  | F | G  | H | I  | J | K  | L | M |
|----|----|---|----|---|----|---|----|---|----|---|----|---|---|
| 2  | 6  |   | 5  |   | 4  |   | 3  |   | 2  |   | 1  |   |   |
| 3  |    |   |    |   |    |   |    |   |    |   |    |   |   |
| 4  | 7  |   | 8  |   | 9  |   | 10 |   | 11 |   | 12 |   |   |
| 5  |    |   |    |   |    |   |    |   |    |   |    |   |   |
| 6  | 18 |   | 17 |   | 16 |   | 15 |   | 14 |   | 13 |   |   |
| 7  |    |   |    |   |    |   |    |   |    |   |    |   |   |
| 8  | 19 |   | 20 |   | 21 |   | 22 |   | 23 |   | 24 |   |   |
| 9  |    |   |    |   |    |   |    |   |    |   |    |   |   |
| 10 | 30 |   | 29 |   | 28 |   | 27 |   | 26 |   | 25 |   |   |
| 11 |    |   |    |   |    |   |    |   |    |   |    |   |   |
| 12 | 31 |   | 32 |   | 33 |   | 34 |   | 35 |   | 36 |   |   |
| 13 |    |   |    |   |    |   |    |   |    |   |    |   |   |

I, Donald G. Sandel, in a field survey on November 29, 1999 hereby certify that under requirements of P.A. 74, Michigan P.A. of 1970, the corner points mentioned in lines 1 and 2 above were in conformance with regulations and rules therefore as required in the current manual of survey instructions of the United States Department of the Interior, Bureau of Land Management or by a decree of a Court of Law and/or that the corner points mentioned in lines 3, 4 and 5 above were in conformance with the rules of the Michigan Board of Land Surveyors or by a Decree of a Court of Law; established, re-established, monumented, re-monumented, recovered, found as expressed below:



NOTE: Not more than 4 corners, all in the same town and range, may be recorded on this certificate.

500  
4113199

A. Description of original monument and accessories and/or subsequent restoration:  
 (1) GLO: set quarter section post, April 4, 1838: Beech 10" N16°E .20 chains; Beech 8" S32°W .46 chains  
 (2) Muskegon County Road Commission, date unknown, PK nail:  
 SE Guy Pole, 45.32 SW Telephone Pole, 55.09' NNE Power Pole, 90.73'  
 WNW Telephone Pole, 88.70'

B. Description of corner evidence found and/or method applied in restoring or reestablishing corner:  
 (1) Found monument box with nothing in it at intersection of Ochs Road (gravel to north - Asphalt to South) and Fruitvale Road (E/W Asphalt). Excavated to depth of 36". Witnesses to utility pole to NE and utility pole stump to SE checked to center of monument box. Used these to reset corner.  
 (2) Historical usage, documentation, and evidence of corner location reviewed and ratified by the Muskegon County Peer Group, April 13, 1999.

C. Description of monument for corner and accessories established to perpetuate locating the position of the corner:  
 Set 2 3/4" D X 31" Cast Iron "County Survey" monument in monument box using existing witnesses; witnessed as follows:  
 N22°E found nail SE side utility pole, 90.73'  
 S26°E found nail SW side utility pole stump, 45.32'  
 S04°W set mag nail at centerline (not on section line) Ochs Road, 37.65'  
 N85°W set mag nail at centerline (not on section line) Fruitvale Road, 35.81'  
 N65°W set center of top GTE riser, 92.78'  
 N27°W set E edge of post stop sign, 41.60'

 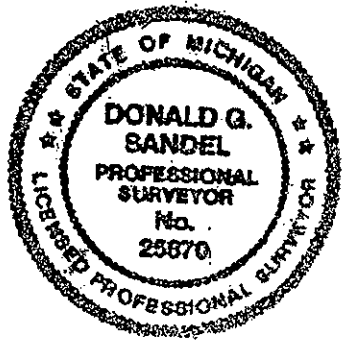

Signed by Donald G. Sandel Date 13 December 1999  
 Surveyor's Michigan License No. 25870

A.20.23