

JAN 31 2001

LAND CORNER RECORDATION CERTIFICATE Filing Requirement of Act 74, Mich. P.A. 1970

2001 DEC 20 PM 1:52

For corners SECTION Muskegon County

Located in: Corner Code #

1. Public Land Survey T 12N R 17W E-2

T _____ R _____

T _____ R _____

T _____ R _____

2. Property Controlling in Section S _____ T _____ R _____

S _____ T _____ R _____

3. Miscellaneous Property in Sec. S _____ T _____ R _____

S _____ T _____ R _____

4. Lot No _____, Recorded Plat _____

5. Private Claims _____

Mark Fairchild REGISTER OF DEEDS

Register of Deeds Stamp & File Number

I, Donald G. Sandel, in a field survey on July 10, 2000 hereby certify that under requirements of P.A. 74, Michigan P.A. of 1970, the corner points mentioned in lines 1 and 2 above were in conformance with regulations and rules therefore as required in the current manual of survey instructions of the United States Department of the Interior, Bureau of Land Management or by a decree of a Court of Law and/or that the corner points mentioned in lines 3, 4 and 5 above were in conformance with the rules of the Michigan Board of Land Surveyors or by a Decree of a Court of Law; established, re-established, monumented, re-monumented, recovered, found as expressed below:

	A	B	C	D	E	F	G	H	I	J	K	L	M
2	6	5	4	3	2	1							
3													
4	7	8	9	10	11	12							
5													
6	18	17	16	15	14	13							
7													
8	19	20	21	22	23	24							
9													
10	30	29	28	27	26	25							
11													
12	31	32	33	34	35	36							
13													

NOTE: Not more than 4 corners, all in the same town and range, may be recorded on this certificate.

A. Description of original monument and accessories and/or subsequent restoration:

- GLO: Set Quarter Section Post, April 12, 1838: Pine 20" N47°W .16 chains, Pine 16" N73°E .16 chains.
- R.L. Roon #13593 on 11-19-68 found 3/4" Pipe: S45°W 45.12' 22" Oak, N50°W 78.57' 18" Oak, N85°E 54.89' 15" Oak, S65°E 63.79' 28" Oak.
- E. Scharmer Jr. #4156 on 2-26-71 found 1" Pipe: 40.1' SW Spike 10" Black Oak, 61.1' SE Spike 30" Black Oak, 56.8' ENE Spike 12" Black Oak.
- Muskegon County Road Commission 1 1/4" Pinched Pipe: N35°E 62.58' 10" Oak, S73°E 61.19' 29" Oak MSHD Tag, N47°W 83.19' 20" Oak MSHD Tag, SSW 40.25' 24" Oak Nail S side.
- D. G. Sandel #25870 on 5-15-79 found 3/4" Pinched Pipe in Monument Box at Center Line of Sikkenga Road: N34°E Nail W side 8" Oak 62.61', S72°E Nail S side 30" Oak- large Nail 61.04', small Nail 61.21', S55°W Nail S side 24" Oak 40.24', N47°W Nail w/MSHD Tag S side 18" Oak 83.22'.

B. Description of corner evidence found and/or method applied in restoring or reestablishing corner:


- Found 3/4" Pinched Pipe 19" long in Monument Box at Center Line of Sikkenga Road. (N/S Asphalt). Used existing witnesses to verify corner location.
- Historical usage, documentation, and evidence of corner location reviewed and ratified by the Muskegon County Peer Group, May 2, 2000.

C. Description of monument for corner and accessories established to perpetuate locating the position of the corner:

Set 2 3/4" x 31" Cast Iron "County Survey" Monument stamped #25870 in place of found 3/4" Pinched Pipe; witnessed as follows:

- N25°E, set 1/2" Rebar at E edge of Asphalt, 26.80'
- S25°E, set Nail SW side, 20" Oak, 86.30'
- S70°E, found Nail S side, 30" dead Oak, 61.04'
- S85°E, set Nail N side, Utility Pole, 42.20'
- S26°W, set Nail SE side, 8" Pine, 81.95'
- S58°W, found Nail SE side, 29" Oak, 40.11'
- N14°W, set Nail NE side, Utility Pole, 114.73'

POSITION OF SAID RECORDED CORNER REVIEWED & RATIFIED BY MUSKEGON COUNTY PEER GROUP IN ACCORDANCE WITH P.A. 345, OF 1990

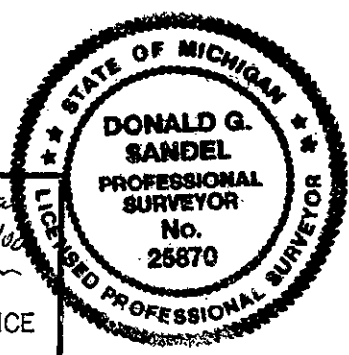

Signed by Donald G. Sandel Surveyor's Michigan License No. 25870

Date 15 December 2000

A2151