

MAR 09 1999

**LAND CORNER RECORDATION CERTIFICATE**  
**Filing Requirement of Act 74, Mich. P.A. 1970**

STATE OF MICHIGAN  
 COUNTY OF MUSKEGON  
 RECEIVED FOR RECORD

For corners in SECTION  
 Muskegon County

Located in: Corner Code #

- |                                      |                           |       |
|--------------------------------------|---------------------------|-------|
| 1. Public Land Survey                | T <u>12N</u> R <u>17W</u> | J-7   |
|                                      | T _____ R _____           | _____ |
|                                      | T _____ R _____           | _____ |
|                                      | T _____ R _____           | _____ |
| 2. Property Controlling in Section   | S _____ T _____ R _____   | _____ |
|                                      | S _____ T _____ R _____   | _____ |
| 3. Miscellaneous Property in Sec.    | S _____ T _____ R _____   | _____ |
|                                      | S _____ T _____ R _____   | _____ |
| 4. Lot No _____, Recorded Plat _____ |                           |       |
| 5. Private Claims _____              |                           |       |

1998 DEC -8 PM 3: 33

*Carrie Carter*  
 REGISTER OF DEEDS

LIBER **2181** PAGE **594**

Register of Deeds Stamp & File Number

	A	B	C	D	E	F	G	H	I	J	K	L	M
2		6		5		4		3		2		1	
3													
4		7		8		9		10		11		12	
5													
6		18		17		16		15		14		13	
7										⊙			
8		19		20		21		22		23		24	
9													
10		30		29		28		27		26		25	
11													
12		31		32		33		34		35		36	
13													

I, Donald G. Sandel, in a field survey on June 29, 1998 hereby certify that under requirements of P.A. 74, Michigan P.A. of 1970, the corner points mentioned in lines 1 and 2 above were in conformance with regulations and rules therefore as required in the current manual of survey instructions of the United States Department of the Interior, Bureau of Land Management or by a decree of a Court of Law and/or that the corner points mentioned in lines 3, 4 and 5 above were in conformance with the rules of the Michigan Board of Land Surveyors or by a Decree of a Court of Law; established, re-established, monumented, re-monumented, recovered, found as expressed below:

NOTE: Not more than 4 corners, all in the same town and range, may be recorded on this certificate.

A. Description of original monument and accessories and/or subsequent restoration:

- (1) GLO: set quarter section post in marsh, no trees, March 28, 1838.
- (2) MCRC (1950's) witnesses: 1" pipe; witnessed as follows:
  - S60°W found 1/2" rod 61.63'
  - N15°W Twin 18" Ash 102.50'
  - East 15' River


B. Description of corner evidence found and/or method applied in restoring or reestablishing corner:

- (1) Found 1" Pipe 15'+/- Southwest of South bank of Silver Creek. Verified corner location using existing witnesses.
- (2) Historical usage, documentation, and evidence of corner location reviewed and ratified by the Muskegon County Peer Group, April 7, 1998.

C. Description of monument for corner and accessories established to perpetuate locating the position of the corner:

Set 3" X 31" Cast Iron "County Survey" monument in place of found 1" pipe, also set 5' tall orange marker reading "survey marker" near it; witnessed as follows:  
 N40°E, set south bank of Silver Creek, 13.00'  
 S35°W, set center 1' above ground, 1" Pipe, 34.85'  
 S60°E, set south bank of southern most bend of Silver Creek, 77.00'  
 S16°E, set NW edge, 10' diameter brush clump, 283.00'  
 S83°W, set NE edge, 30' diameter brush clump, 143.00'  
 N56°W, set nail SE side, 22" twin ash, 105.28'

POSITION OF SAID  
 RECORDED CORNER  
 REVIEWED & RATIFIED  
 BY MUSKEGON COUNTY  
 PEER GROUP IN ACCORDANCE  
 WITH P.A. 345, OF 1990

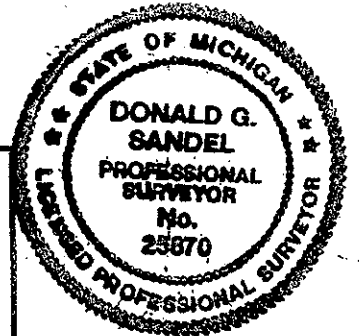

Signed by Donald G. Sandel Date 14 September 1998  
 Surveyor's Michigan License No. 25870

A1953