

SURVEY A  
 REMOVED  
 APR 26 1998

**LAND CORNER RECORDATION CERTIFICATE**  
**Filing Requirement of Act 74, Mich. P.A. 1970**

STATE OF MICHIGAN  
 COUNTY OF MUSKEGON  
 RECEIVED FOR RECORD

1998 DEC -8 PM 3:33

*Carrie Carter*  
 REGISTER OF DEEDS

LIBER **2181** PAGE **598**

Register of Deeds Stamp & File Number

SECTION

For corners in Muskegon County Located in: Corner Code #

1. Public Land Survey T 12N R 17W K-7  
 T \_\_\_\_\_ R \_\_\_\_\_  
 T \_\_\_\_\_ R \_\_\_\_\_  
 T \_\_\_\_\_ R \_\_\_\_\_

2. Property Controlling S \_\_\_\_\_ T \_\_\_\_\_ R \_\_\_\_\_  
 in Section S \_\_\_\_\_ T \_\_\_\_\_ R \_\_\_\_\_

3. Miscellaneous S \_\_\_\_\_ T \_\_\_\_\_ R \_\_\_\_\_  
 Property in Sec. S \_\_\_\_\_ T \_\_\_\_\_ R \_\_\_\_\_

4. Lot No \_\_\_\_\_, Recorded Plat \_\_\_\_\_

5. Private Claims \_\_\_\_\_

	A	B	C	D	E	F	G	H	I	J	K	L	M
2	6		5		4		3		2		1		
3													
4	7		8		9		10		11		12		
5													
6	18		17		16		15		14		13		
7													
8	19		20		21		22		23		24		
9													
10	30		29		28		27		26		25		
11													
12	31		32		33		34		35		36		
13													

I, Donald G. Sandel, in a field survey on May 13, 1998 hereby certify that under requirements of P.A. 74, Michigan P.A. of 1970, the corner points mentioned in lines 1 and 2 above were in conformance with regulations and rules therefore as required in the current manual of survey instructions of the United States Department of the Interior, Bureau of Land Management or by a decree of a Court of Law and/or that the corner points mentioned in lines 3, 4 and 5 above were in conformance with the rules of the Michigan Board of Land Surveyors or by a Decree of a Court of Law; established, re-established, monumented, re-monumented, recovered, found as expressed below:


NOTE: Not more than 4 corners, all in the same town and range, may be recorded on this certificate.

- A. Description of original monument and accessories and/or subsequent restoration:
- (1) GLO: set post corner Sections 13, 14, 23 and 24: W. Oak 10" S46°E .16 chains  
 W. Oak 6" N61°E .10 chains
  - (2) Muskegon County Road Commission; witnessed as follows:  
 S35°E 12" twin oak 27.12'; NNE 8" oak 36.38'; NE 16" oak 40.95'; WSW 14" oak 35.45'

- B. Description of corner evidence found and/or method applied in restoring or reestablishing corner:
- (1) Found 1" pinched pipe 30" long 11' south of trail running E/W and 25' E of trail running south. Verified corner location using existing witnesses.
  - (2) Historical usage, documentation, and evidence of corner location reviewed and ratified by the Muskegon County Peer Group, April 7, 1998.

- C. Description of monument for corner and accessories established to perpetuate locating the position of the corner:
- Set 3"D X 31" Cast Iron "County Survey" monument in place of found 1" pinched pipe; witnessed as follows:  
 N15°E, set nail W side, 10" oak, 19.45'  
 N55°E, set nail W side, 22" oak, 40.89'  
 S35°E, set nail NE side, 18" oak, 27.23'  
 S08°E, set nail NE side, 18" oak, 20.56'  
 S77°W, found nail S side, 10" oak, 35.42'  
 N52°W, set nail S side, 12" twin oak, 10.74'

POSITION OF SAID  
 RECORDED CORNER  
 REVIEWED & RATIFIED  
 BY MUSKEGON COUNTY  
 PEER GROUP IN ACCORDANCE  
 WITH P.A. 345, OF 1990

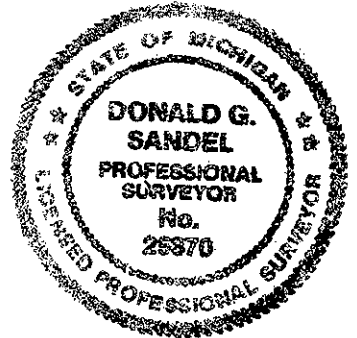

Signed by Donald G. Sandel Date 10 November 1998  
 Surveyor's Michigan License No. 25870

A1957