

DATE 10 2000

SECTION

LAND CORNER RECORDATION CERTIFICATE
Filing Requirement of Act 74, Mich. P.A. 1970

MARQUETTE COUNTY
MICHIGAN
RECEIVED FOR RECORD
1999 DEC 29 PM 2:45

Patricia A. Manley
REGISTER OF DEEDS

For corners in

<u>MARQUETTE</u> (County)	Located In:	Corner Code #
1. Public Land Survey	T 43 N R 24 W	F-13 SAME
	T 42 N R 24 W	F-1 CORNER ✓
	T 43 N R 24 W	G-13 SAME
	T 42 N R 24 W	G-1 CORNER
2. Property Controlling in Section	S T R	
	S T R	
3. Miscellaneous Property in Sec.	S T R	
	S T R	

LIBER **R 2** PAGE 237
Register of Deeds Stamp & File Number

F-1 [N1/4 COR SEC 4] G-1 [NW COR SEC 3]

4. Lot No. _____, Recorded Plat _____
5. Private Claims _____

I, M.P. DAVIS, in a field survey on DECEMBER, 19 99 do hereby state that under requirements of P.A. 74, Michigan P.A. of 1970, the corner points mentioned in lines 1 and 2 above were in conformance with regulations and rules therefore as required in the current manual of survey instructions of the United States Department of the Interior, Bureau of Land Management or by a decree of a Court of Law and/or that the corner points mentioned in lines 3, 4 and 5 above were in conformance with the rules of the Michigan Board of Land Surveyors or by a Decree of a Court of Law, established, re-established, monumented, recovered, found as expressed below:

NOTE: Not more than 2 corners, all in the same town and range, may be recorded on this certificate.


1	A	B	C	D	E	F	G	H	I	J	K	L	M
2		6		5		4		3		2		1	
3													
4		7		8		9		10		11		12	
5													
6		18		17		16		15		14		13	
7													
8		19		20		21		22		23		24	
9													
10		30		29		28		27		26		25	
11													
12		31		32		33		34		35		36	
13													

A. Description of original monument and accessories and/or subsequent restoration:

- F-1 [N1/4 COR SEC 4] Wm. A. BURT, D.S.-1841-WOOD POST (FIR 07" N35°E 46 LINKS)(LYNN 14" N40°W 18 LINKS)
NO RECORD EVIDENCE OF CORNER RECOVERY AND/OR SUBSEQUENT REMONUMENTATION.
- G-1 [NW COR SEC 3] Wm. A. BURT, D.S.-1841-WOOD POST (SUGAR 16" N30°E 35 LINKS)(SUGAR 09" N28°W 10 LINKS)
E.C.MARTIN, D.S.-1852-(SUGAR 14" S32°W 24 LINKS)(SUGAR 10" S70°E 31 LINKS)
NO RECORD EVIDENCE OF CORNER RECOVERY AND/OR SUBSEQUENT REMONUMENTATION.

B. Description of corner evidence found and/or method applied in restoring or reestablishing corner:

- F-1 [N1/4 COR SEC 4] NO CORNER EVIDENCE FOUND-REESTABLISHED CORNER POSITION AT THE MIDPOINT AND ON LINE WITH SECTION CORNERS 1/2 MILE EAST AND WEST.
- G-1 [NW COR SEC 3] NO CORNER EVIDENCE FOUND-REESTABLISHED CORNER POSITION FROM EXISTING LINES OF OCCUPATION (ANCIENT FARM FENCE NORTH) AND COUNTY ROAD IMPROVEMENTS (C/L OF EAST-WEST COUNTY ROAD) ACCEPTED AS BEING THE BEST AVAILABLE EVIDENCE AS TO THE LOCATION OF THE POSITION OF THE ORIGINAL CORNER.

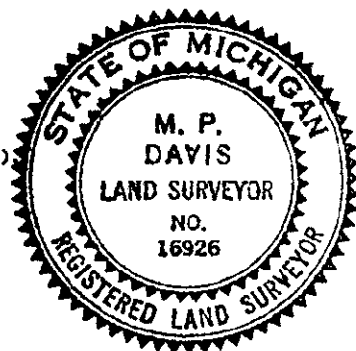

C. Description of monument for corner and accessories established to perpetuate locating the position of the corner:

- F-1 SET A 3/4" X 18" REBAR W/A 3-1/4" ALUM CAP STAMPED TO ID THE CORNER POSITION.
5/8" X 18" IRON PINS W/A RLS CAP DRILL HOLE IN LARGE FIELD STONE NW CORNER OF CONC. BLK GARAGE
N43°W N52°E S47°E S42°W
23.00' 23.50' 63.35' 66.02'
- G-1 SET A 3/4" X 18" REBAR W/A 3-1/4" ALUM CAP STAMPED TO ID THE CORNER POSITION.
DRILL HOLES IN LARGE FIELD STONES IRONWOOD 06" MAPLE 13"
N48°W N33°E S25°E S42°W
59.35' 42.20' 54.27' 52.72'

RATIFIED BY PEER GROUP
P.A. 345 OF 1999
Larry J. Burdick
DATE 12/27/99

NOTE: BEARINGS TO REFERENCE OBJECTS ARE MAGNETIC-DISTANCES ARE TO A NAIL IN THE C/L OF THE OBJECT, UNLESS OTHERWISE NOTED.

Signed by M.P. Davis
Surveyor's Michigan License No. 16926

Date 12/14/99