

RF

JAN 10 2000

SECTION

LAND CORNER RECORDATION CERTIFICATE
Filing Requirement of Act 74, Mich. P.A. 1970

MARQUETTE COUNTY MICHIGAN
RECEIVED FOR RECORD
1999 DEC 29 PM 2:45

Patricia A. Manley
REGISTER OF DEEDS

For corners in

Table with columns: MARQUETTE (County), Located in:, Corner Code #. Rows include Public Land Survey, Property Controlling in Section, and Miscellaneous Property in Sec.

LIBER R 2 PAGE 238
Register of Deeds Stamp & File Number

H-1 [N1/4 COR SEC 3] I-1 [NW COR SEC 2]
4. Lot No. Recorded Plat
5. Private Claims

I, M.P. DAVIS, in a field survey on DECEMBER, 19 99 do hereby state that under requirements of P.A. 74, Michigan P.A. of 1970, the corner points mentioned in lines 1 and 2 above were in conformance with regulations and rules therefore as required in the current manual of survey instructions of the United States Department of the Interior, Bureau of Land Management or by a decree of a Court of Law and/or that the corner points mentioned in lines 3, 4 and 5 above were in conformance with the rules of the Michigan Board of Land Surveyors or by a Decree of a Court of Law; established, re-established, monumented, recovered, found as expressed below:

NOTE: Not more than 2 corners, all in the same town and range, may be recorded on this certificate.


Grid table with columns A-M and rows 1-13. Contains numerical data points for survey locations.

A. Description of original monument and accessories and/or subsequent restoration:

- H-1 [N1/4 COR SEC 3] Wm. A. BURT, D.S.-1841-WOOD POST (HEMLOCK 14" N25°E 50 LINKS)(HEMLOCK 14" N15°W 70 LINKS) NO RECORD EVIDENCE OF CORNER RECOVERY AND/OR SUBSEQUENT REMONUMENTATION.
I-1 [NW COR SEC 2] Wm. A. BURT, D.S.-1841-WOOD POST (SUGAR 22" N65°E 58 LINKS)(LYNN 12" N37°W 12 LINKS) E.C.MARTIN, D.S.-1852-(LYNN 16" S50°W 15 LINKS)(SUGAR 08" S40°E 39 LINKS) NO RECORD EVIDENCE OF CORNER RECOVERY AND/OR SUBSEQUENT REMONUMENTATION.

B. Description of corner evidence found and/or method applied in restoring or reestablishing corner:

- H-1 [N1/4 COR SEC 3] NO CORNER EVIDENCE FOUND-REESTABLISHED CORNER POSITION FROM EXISTING LINES OF OCCUPATIONS (FARM FENCE LINES NORTH & SOUTH, DOWN & IN POOR REPAIR) AND COUNTY ROAD IMPROVEMENTS (C/L OF COUNTY ROAD EAST AND WEST). ACCEPTED AS BEING THE BEST AVAILABLE EVIDENCE AS TO THE LOCATION OF THE POSITION OF THE ORIGINAL CORNER.
I-1 [NW COR SEC 2] NO CORNER EVIDENCE FOUND-REESTABLISHED CORNER POSITION FROM EXISTING LINES OF OCCUPATION (ANCIENT FARM FENCE SOUTH, DOWN & IN POOR REPAIR) AND COUNTY ROAD IMPROVEMENTS (C/L OF EAST-WEST COUNTY ROAD). ACCEPTED AS BEING THE BEST AVAILABLE EVIDENCE AS TO THE LOCATION OF THE POSITION OF THE ORIGINAL CORNER.

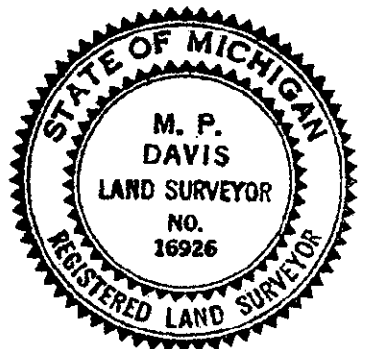

C. Description of monument for corner and accessories established to perpetuate locating the position of the corner:

- H-1 SET A 3/4" X 18" REBAR W/A 3-1/4" ALUM CAP STAMPED TO ID THE CORNER POSITION. CEDAR 14" N20°W 43.21', ELM 06" N25°E 57.50', MAPLE 10" S28°E 62.94', CEDAR 09" S58°W 67.70'
I-1 SET A 3/4" X 18" REBAR W/A 3-1/4" ALUM CAP STAMPED TO ID THE CORNER POSITION. 5/8" X 18" IRON PINS W/A RLS CAP IRONWOOD 06" N47°W 32.10', ELM 08" N62°E 40.53', S38°E 58.67', S17°W 35.31'

RATIFIED BY PEER GROUP
P.A. 345 OF 1990

Larry J. Bussan
DATE 12/27/99

NOTE: BEARINGS TO REFERENCE OBJECTS ARE MAGNETIC-DISTANCES ARE TO A NAIL IN THE C/L OF THE OBJECT, UNLESS OTHERWISE NOTED.

Signed by M.P. Davis Date 12/14/99
Surveyor's Michigan License No. 16926