

MICHIGAN
DEPARTMENT OF CONSERVATION
FORESTRY DIVISION

LAND CORNER RECORD

T. 42. NR. 24. W.


Marquette COUNTY

DESCRIPTION OF CORNER 1/4 Corner between Sections 4 and 5

DESCRIPTION OF CORNER MONUMENT 1-inch galvanized pipe with 1/2-inch brass cap

Date Monument Placed and Witnessed January 23, 1962

WITNESSES TO CORNER

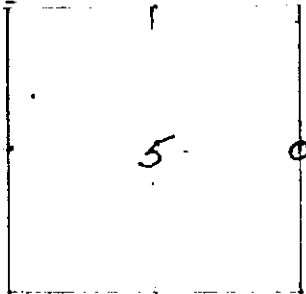

Cedar 9 S87W 30.5 links

Cedar 7 N14W 12.5 links

Cedar 9 S70E 22.5 links

DESCRIPTION IN DETAIL AS TO HOW CORNER WAS LOCATED AND IDENTIFIED OR RESTORED.

This corner was set from the original tamarack BT. This tamarack was a dead tree. Both faces showed plainly with the bottom face showing the "BT" scribe marks distinctly. A squared post stood in proper location. An old blazed cedar tree nearby had been registered on by numerous cruisers, the oldest legible date being 1915. Deep snow hid whatever might have remained of the other BT (spruce).

SURVEYORS SEAL

SIGNED

REGISTERED LAND SURVEYOR

DATE

1/24/62