

SECTION

LAND CORNER RECORDATION CERTIFICATE
 Filing Requirement of Act 74, Mich. P.A. 1970

Patricia H. Manley
 REGISTER OF DEEDS

For corners in

MARQUETTE (County)	Located In:	Corner Code #
1. Public Land Survey	T 43 NR 24 W	D-13 SAME
	T 42 NR 24 W	D-1 CORNER
	T 43 NR 24 W	E-13 SAME ✓
	T 42 NR 24 W	E-1 CORNER
2. Property Controlling in Section	S T R	
	S T R	
3. Miscellaneous Property in Sec.	S T R	
	S T R	

LIBER **R2** PAGE 236
 Register of Deeds Stamp & File Number

D-1 [N1/4 COR SEC 5] E-1 [NW COR SEC 4]

4. Lot No. _____, Recorded Plat _____
 5. Private Claims _____

I, M.P. DAVIS, in a field survey on DECEMBER, 1999 do hereby state that under requirements of P.A. 74, Michigan P.A. of 1970, the corner points mentioned in lines 1 and 2 above were in conformance with regulations and rules therefore as required in the current manual of survey instructions of the United States Department of the Interior, Bureau of Land Management or by a decree of a Court of Law and /or that the corner points mentioned in lines 3, 4 and 5 above were in conformance with the rules of the Michigan Board of Land Surveyors or by a Decree of a Court of Law; established, re-established, monumented, recovered, found as expressed below:

NOTE: Not more than 2 corners, all in the same town and range, may be recorded on this certificate.


1	A	B	C	D	E	F	G	H	I	J	K	L	M
2	6			5		4		3		2		1	
3													
4	7			8		9		10		11		12	
5													
6	18			17		16		15		14		13	
7													
8	19			20		21		22		23		24	
9													
10	30			29		28		27		26		25	
11													
12	31			32		33		34		35		36	
13													

A. Description of original monument and accessories and/or subsequent restoration:

- D-1 [N1/4 COR SEC 4] Wm. A. BURT, D.S.-1841-WOOD POST (HEMLOCK 10" N32°E 30 LINKS)(HEMLOCK 20" N25°W 62 LINKS) NO RECORD EVIDENCE OF CORNER RECOVERY AND/OR SUBSEQUENT REMONUMENTATION.
- E-1 [NW COR SEC 4] Wm. A. BURT, D.S.-1841-WOOD POST (LYNN 10" N66°E 35 LINKS)(LYNN 18" N12°W 19 LINKS) E.C. MARTIN, D.S.-1852-(SUGAR 08" S48°W 11 LINKS)(SUGAR 13" S29°E 17 LINKS) NO RECORD EVIDENCE OF CORNER RECOVERY AND/OR SUBSEQUENT REMONUMENTATION.

B. Description of corner evidence found and/or method applied in restoring or reestablishing corner:

- D-1 [N1/4 COR SEC 4] FOUND IN PLACE A 3/4" X 24" IRON PIPE ON APPROXIMATE C/L OF E-W COUNTY RD. CORNER SET BY PERSONS UNKNOWN. ACCEPTED EXISTING MONUMENT AS BEING THE BEST AVAILABLE EVIDENCE AS TO THE LOCATION OF THE POSITION OF THE ORIGINAL CORNER.
- E-1 [NW COR SEC 4] NO CORNER EVIDENCE FOUND-REESTABLISHED CORNER POSITION ON THE C/L OF THE E-W COUNTY ROAD AND AT A PROPORTIONATE DISTANCE EAST AND WEST BETWEEN THE N1/4 COR. OF SEC. 5 AND THE NE CORNER OF SECTION 4.

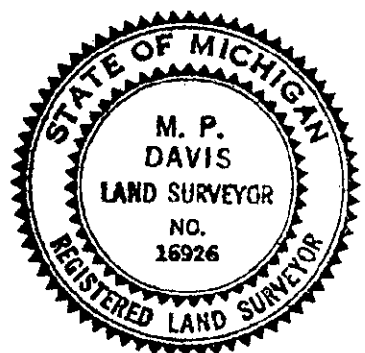

C. Description of monument for corner and accessories established to perpetuate locating the position of the corner:

- D-1 SET A 3/4" X 18" REBAR W/A 3-1/4" ALUM CAP STAMPED TO ID THE CORNER POSITION.

BALSAM 06"	MAPLE 05"	BALSAM 07"	BALSAM 06"
N46°W	N48°E	S41°E	S14°W
59.63'	38.31'	32.91'	36.20'
- E-1 SET A 3/4" X 18" REBAR W/A 3-1/4" ALUM CAP STAMPED TO ID THE CORNER POSITION.

BASSWOOD 07"	Y. BIRCH 12"	MAPLE 12"	MAPLE 08"
N48°W	N33°E	S30°E	S50°W
59.35'	42.20'	34.75'	82.85'

RATIFIED BY PEER GROUP
 P.A. 345 OF 1990

Larry J. Bassant
 DATE 12/27/99

NOTE: BEARINGS TO REFERENCE OBJECTS ARE MAGNETIC-DISTANCES ARE TO A NAIL IN THE C/L OF THE OBJECT, UNLESS OTHERWISE NOTED.

Signed by M.P. Davis
 Surveyor's Michigan License No. 16926

Date 12/14/99