

MAR 10 1990

MARQUETTE COUNTY MICHIGAN RECEIVED FOR RECORD

1999 DEC 29 PM 2:45

SECTION

LAND CORNER RECORDATION CERTIFICATE Filing Requirement of Act 74, Mich. P.A. 1970

For corners in

Patricia A. Stanley REGISTER OF DEEDS

Table with columns: MARQUETTE (County), Located In:, Corner Code #. Rows include Public Land Survey, Property Controlling in Section, and Miscellaneous Property in Sec.

LIBER R2 PAGE 238 Register of Deeds Stamp & File Number

H-1 [N1/4 COR SEC 3] I-1 [NW COR SEC 2]

4. Lot No. , Recorded Plat 5. Private Claims

M.P. DAVIS, in a field survey on DECEMBER 19 99 do hereby state that under requirements of P.A. 74, Michigan P.A. of 1970, the corner points mentioned in lines 1 and 2 above were in conformance with regulations and rules therefore as required in the current manual of survey instructions of the United States Department of the Interior, Bureau of Land Management or by a decree of a Court of Law and /or that the corner points mentioned in lines 3, 4 and 5 above were in conformance with the rules of the Michigan Board of Land Surveyors or by a Decree of a Court of Law; established, re-established, monumented, recovered, found as expressed below.

Grid table with columns A-L and rows 1-13. Contains numerical data for survey points.

NOTE: Not more than 2 corners, all in the same town and range, may be recorded on this certificate.

A. Description of original monument and accessories and/or subsequent restoration:


H-1 [N1/4 COR SEC 3] Wm. A. BURT, D.S.-1841-WOOD POST (HEMLOCK 14" N25°E 50 LINKS)(HEMLOCK 14" N15°W 70 LINKS) NO RECORD EVIDENCE OF CORNER RECOVERY AND/OR SUBSEQUENT REMONUMENTATION.

I-1 [NW COR SEC 2] Wm. A. BURT, D.S.-1841-WOOD POST (SUGAR 22" N65°E 58 LINKS)(LYNN 12" N37°W 12 LINKS) E.C. MARTIN, D.S.-1852-(LYNN 16" S50°W 15 LINKS)(SUGAR 08" S40°E 39 LINKS) NO RECORD EVIDENCE OF CORNER RECOVERY AND/OR SUBSEQUENT REMONUMENTATION.

B. Description of corner evidence found and/or method applied in restoring or reestablishing corner:

H-1 [N1/4 COR SEC 3] NO CORNER EVIDENCE FOUND-REESTABLISHED CORNER POSITION FROM EXISTING LINES OF OCCUPATIONS (FARM FENCE LINES NORTH & SOUTH, DOWN & IN POOR REPAIR) AND COUNTY ROAD IMPROVEMENTS (C/L OF COUNTY ROAD EAST AND WEST). ACCEPTED AS BEING THE BEST AVAILABLE EVIDENCE AS TO THE LOCATION OF THE POSITION OF THE ORIGINAL CORNER.

I-1 [NW COR SEC 2] NO CORNER EVIDENCE FOUND-REESTABLISHED CORNER POSITION FROM EXISTING LINES OF OCCUPATION (ANCIENT FARM FENCE SOUTHWEST, DOWN & IN POOR REPAIR) AND COUNTY ROAD IMPROVEMENTS (C/L OF EAST-WEST COUNTY ROAD). ACCEPTED AS BEING THE BEST AVAILABLE EVIDENCE AS TO THE LOCATION OF THE POSITION OF THE ORIGINAL CORNER.

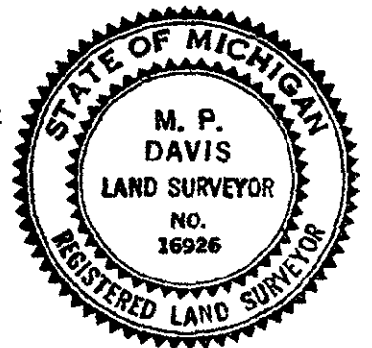

C. Description of monument for corner and accessories established to perpetuate locating the position of the corner:

H-1 SET A 3/4" X 18" REBAR W/A 3-1/4" ALUM CAP STAMPED TO ID THE CORNER POSITION. CEDAR 14" ELM 06" MAPLE 10" CEDAR 09" N20°W 43.21' N25°E 57.50' S28°E 62.94' S58°W 67.70'

I-1 SET A 3/4" X 18" REBAR W/A 3-1/4" ALUM CAP STAMPED TO ID THE CORNER POSITION. 5/8" X 18" IRON PINS W/A RLS CAP IRONWOOD 06" ELM 08" N47°W 32.10' N62°E 40.53' S38°E 58.67' S17°W 35.31'

RATIFIED BY PEER GROUP P.A. 345 OF 1990

Signature of Larry J. Bussan DATE 12/27/99

NOTE: BEARINGS TO REFERENCE OBJECTS ARE MAGNETIC-DISTANCES ARE TO A NAIL IN THE C/L OF THE OBJECT, UNLESS OTHERWISE NOTED.

Signed by M.P. Davis Surveyor's Michigan License No. 16926

Date 12/14/99