

RF

10 2000

MARQUETTE COUNTY MICHIGAN RECEIVED FOR RECORD

1999 DEC 29 PM 2:45

SECTION

LAND CORNER RECORDATION CERTIFICATE Filing Requirement of Act 74, Mich. P.A. 1970

Patricia A. Monahan REGISTER OF DEEDS

For corners in

Table with columns: MARQUETTE (County), Located In:, Corner Code #. Rows include Public Land Survey, Property Controlling in Section, and Miscellaneous Property in Sec.

LIBER R2 PAGE 239 Register of Deeds Stamp & File Number

J-1 [N1/4 COR SEC 2] K-1 [NW COR SEC 1]

4. Lot No. , Recorded Plat 5. Private Claims

I, M.P. DAVIS, in a field survey on DECEMBER 19 99 do hereby state that under requirements of P.A. 74, Michigan P.A. of 1970, the corner points mentioned in lines 1 and 2 above were in conformance with regulations and rules therefore as required in the current manual of survey instructions of the United States Department of the Interior, Bureau of Land Management or by a decree of a Court of Law and /or that the corner points mentioned in lines 3, 4 and 5 above were in conformance with the rules of the Michigan Board of Land Surveyors or by a Decree of a Court of Law; established, re-established, monumented, recovered, found as expressed below:

NOTE: Not more than 2 corners, all in the same town and range, may be recorded on this certificate.


Grid table with columns A-M and rows 1-13. Contains numbers 1-36.

A. Description of original monument and accessories and/or subsequent restoration:

- J-1 [N1/4 COR SEC 2] Wm. A. BURT, D.S.-1841-HEMLOCK 14" CORNER TREE (HEMLOCK 20" N85°E 16 LINKS) NO RECORD EVIDENCE OF CORNER RECOVERY AND/OR SUBSEQUENT REMONUMENTATION. K-1 [NW COR SEC 1] Wm. A. BURT, D.S.-1841-WOOD POST (CEDAR 09" N15°E 15 LINKS) (CEDAR 10" N18°W 30 LINKS) E.C. MARTIN, D.S.-1852-(CEDAR 10" S58°E 21 LINKS) NO RECORD EVIDENCE OF CORNER RECOVERY AND/OR SUBSEQUENT REMONUMENTATION.

B. Description of corner evidence found and/or method applied in restoring or reestablishing corner:

- J-1 [N1/4 COR SEC 2] NO CORNER EVIDENCE FOUND-REESTABLISHED CORNER POSITION ON LINE WITH NW CORNER OF SEC 2 AND NE CORNER OF SEC 1 AND IN LINE WITH ANCIENT FARM FENCE LINES NORTH & SOUTH WHICH ARE DOWN & IN POOR REPAIR. ACCEPTED AS BEING THE BEST AVAILABLE EVIDENCE AS TO THE LOCATION OF THE POSITION OF THE ORIGINAL CORNER. K-1 [NW COR SEC 1] NO CORNER EVIDENCE FOUND-REESTABLISHED CORNER POSITION ON LINE WITH NW CORNER OF SEC. 2 & NE CORNER OF SEC. 1 AND ON C/L OF COUNTY ROAD TO THE NORTH. ACCEPTED AS BEING THE BEST AVAILABLE EVIDENCE AS TO THE LOCATION OF THE POSITION OF THE ORIGINAL CORNER.

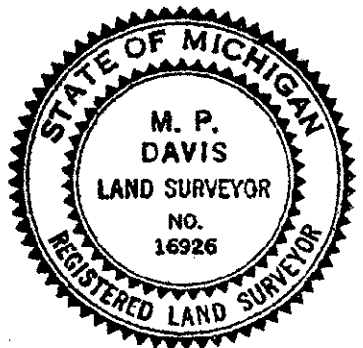

C. Description of monument for corner and accessories established to perpetuate locating the position of the corner:

- J-1 SET A 3/4" X 18" REBAR W/A 3-1/4" ALUM CAP STAMPED TO ID THE CORNER POSITION. DRILL HOLE IN LARGE FIELD STONE SPRUCE 04" CEDAR 11" CEDAR 09" N07°W 39.70' N23°E 45.76' S10°W 37.67' S40°W 41.24' K-1 SET A 3/4" X 18" REBAR W/A 3-1/4" ALUM CAP STAMPED TO ID THE CORNER POSITION. TAMARACK 06" POWER POLE RED PINE 13" SPRUCE 11" N32°W 63.52' N38°E 42.00' S50°E 60.22' S42°W 41.65'

RATIFIED BY PEER GROUP P.A. 345 OF 1998 Larry J. Busome DATE 12/27/99

NOTE: BEARINGS TO REFERENCE OBJECTS ARE MAGNETIC-DISTANCES ARE TO A NAIL IN THE C/L OF THE OBJECT, UNLESS OTHERWISE NOTED.

Signed by M.P. Davis Surveyor's Michigan License No. 16926

Date 12/14/99