

**SURVEY & REMONUMENTATION**

MAR 13 1998

MARQUETTE COUNTY MICHIGAN RECEIVED FOR RECORD

1997 DEC 26 PM 12:38

**SECTION**

**LAND CORNER RECORDATION CERTIFICATE**

Filing Requirement of Act 74, Mich. P.A. 1970

For corners in

MARQUETTE

(County)

Located In:

Corner Code #

1. Public Land Survey	T 42 NR 24 W	M-1 & M-2
	T 43 NR 24 W	M-13
	T R	
	T R	
2. Property Controlling in Section	S T R	
	S T R	
3. Miscellaneous Property in Sec.	S T R	
	S T R	

*Patricia L. Monney*  
REGISTER OF DEEDS

LIBER 2 PAGE 01  
Register of Deeds Stamp & File Number

4. Lot No. \_\_\_\_\_, Recorded Plat \_\_\_\_\_  
5. Private Claims \_\_\_\_\_

M-1 [NE COR S.1 (SAME AS N-13 T43N R24W)] M-2 [E1/4 COR S.1]  
MONUMENTED AS PART OF DELTA COUNTY'S 1996 REMONUMENTATION PLAN

I, M.P. DAVIS, in a field survey on 07 JULY, 19 96, do hereby certify that under requirements of P.A. 74, Michigan P.A. of 1970, the corner points mentioned in lines 1 and 2 above were in conformance with regulations and rules therefore as required in the current manual of survey instructions of the United States Department of the Interior, Bureau of Land Management or by a decree of a Court of Law and/or that the corner points mentioned in lines 3, 4 and 5 above were in conformance with the rules of the Michigan Board of Land Surveyors or by a Decree of a Court of Law; established, re-established, monumented, re-monumented, recovered, found as expressed below:

A	B	C	D	E	F	G	H	I	J	K	L	M
2	6	5	4	3	2	1						
3												
4	7	8	9	10	11	12						
5												
6	18	17	16	15	14	13						
7												
8	19	20	21	22	23	24						
9												
10	30	29	28	27	26	25						
11												
12	31	32	33	34	35	36						
13												

**NOTE: Not more than 4 corners, all in the same town and range, may be recorded on this certificate.**

**A. Description of original monument and accessories and/or subsequent restoration:**

M-1 [NE COR S.1] WILLIAM BURT, D.S. - 1841 - WOOD POST (BIRCH 16"-N45°E-23 LINKS) (BIRCH 10"-S22°W-NO DISTANCE GIVEN)  
NO RECORD EVIDENCE OF CORNER RECOVERY OR SUBSEQUENT REMONUMENTATION

M-2 [E1/4 COR S.1] WILLIAM BURT, D.S. - 1841 - WOOD POST (HEMLOCK 10"-S24°E-23 LINKS) (CEDAR 08"-N44°W-23 LINKS)  
NO RECORD EVIDENCE OF CORNER RECOVERY OR SUBSEQUENT REMONUMENTATION


RATIFIED BY PEER GROUP  
P.A. 345 OF 1990

*Larry J. Bassett*  
DATE 12/15/97

**B. Description of corner evidence found and/or method applied in restoring or reestablishing corner:**

M-1 [NE COR S.1] FOUND IN PLACE A 1" IRON PIPE BY PERSONS UNKNOWN. ID CORNER POSITION FROM EXISTING IMPROVEMENTS (C/L COUNTY ROADS E-W & S AND ANCIENT FENCE LINE NORTH). NO OTHER EVIDENCE VISIBLE. ACCEPTED EXISTING MONUMENT AS THE BEST AVAILABLE EVIDENCE AS TO THE POSITION OF THE ORIGINAL CORNER.

M-2 [E1/4 COR S.1] NO CORNER EVIDENCE FOUND. REESTABLISHED CORNER POSITION A MIDPOINT BETWEEN SECTION CORNERS 1/2 MILE NORTH & SOUTH.

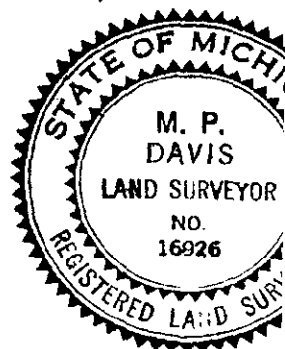

**C. Description of monument for corner and accessories established to perpetuate locating the position of the corner:**

M-1 SET OVER EXISTING MON A 5/8" X 18" REBAR W/A 3 1/4" ALUM CAP STAMPED TO ID THE CORNER POSITION & RAISED TO GRADE W/A MONUMENT B POWER POLE HOLE EAST END CMP SPRUCE 6" SPRUCE 5" SURVEY MONUMENT SIGN POST  
N48°W N57°E S42°E S44°W NORTH  
42.85' 36.42' 61.50' 60.21' 16.20' (TO FACE)

M-2 SET, 6" BELOW GRADE, A 5/8" X 18" REBAR W/A 3 1/4" ALUM CAP STAMPED TO ID THE CORNER POSITION  
SPRUCE 20" SPRUCE 4 SURVEY MONUMENT SIGN POST  
N35°W S45°W EAST  
65.47' 35.51' 22.51' (TO FACE)

**NOTE: BEARINGS TO REFERENCE OBJECTS ARE MAGNETIC & DISTANCES ARE TO A NAIL IN THE CENTER OF THE OBJECT, UNLESS OTHERWISE NOTED.**

Signed by M.P. Davis Date 12/26/96

Surveyor's Michigan License No. 16926